

NOTE:  
ALL LIGHTS ARE INSTALLED IN SHOULDER, 3M FROM PAVEMENT EDGE.


RUNWAY EDGE LIGHTS IN 06 END, GRID 01~13 & GRID 60~72 IS ILLUMINATED IN YELLOW COLOR  
RUNWAY EDGE LIGHTS IN 24 END, GRID 27~36 & GRID 37~46 IS ILLUMINATED IN YELLOW COLOR

AIRFIELD LIGHTING LAYOUT

Scale 1:7000



| SYMBOL | DESCRIPTION        | LOCATION                          | QTY |
|--------|--------------------|-----------------------------------|-----|
|        | EDGE LIGHTS        | RUNWAY EDGE                       | 73  |
|        | EDGE LIGHTS        | TAXIWAY, APRON & TURNING PAD EDGE | 38  |
|        | END LIGHTS         | RUNWAY END                        | 12  |
|        | INSET LIGHTS       | RUNWAY (GRID-1)                   | 01  |
|        | FLOOD LIGHTS/ MAST | APRON LANDSIDE EDGE               | 04  |
|        | APAPI              | 300M FROM RUNWAY PHYSICAL ENDS    | 02  |
|        | WIND CONE / WDI    | AS SHOWN                          | 01  |

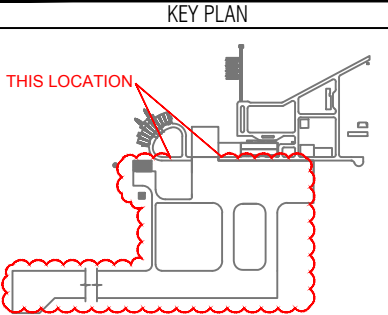

19-08-2019  
M. PRABHU  
CONSULTANT SIGNATURE  
DATE

APPROVAL OF REGIONAL AIRPORT  
MALDIVES  
DATE

| REFERENCE CONSTRUCTION DRAWING NUMBER | REV |
|---------------------------------------|-----|
| T1713-TOS-33000-CV-DW-0001            | A4  |

| AS-BUILT    |            |
|-------------|------------|
| Description | Date       |
| AS-BUILT    | 19/08/2019 |

DRAWING STATUS ☒ APPROVED ☐ REJECTED

N. MAAFARU AIRPORT  
AIRFIELD LIGHTING &  
LANDING AIDS

Drawing Title:  
AIRFIELD LIGHTING LAYOUT

Employer:  
REGIONAL AIRPORTS  
MINISTRY OF TOURISM


Funder:  
  
صندوق أبوظبي للتنمية  
ABU DHABI FUND FOR DEVELOPMENT

Contractor:


Consultant:

Supervision & Management Consultant:

Issue: AB Date: AUG-2019 Pages: 01 of 38  
Scale: N.T.S Paper: A3  
DWG #: T1713-TOS-33000-CV-DW-0001

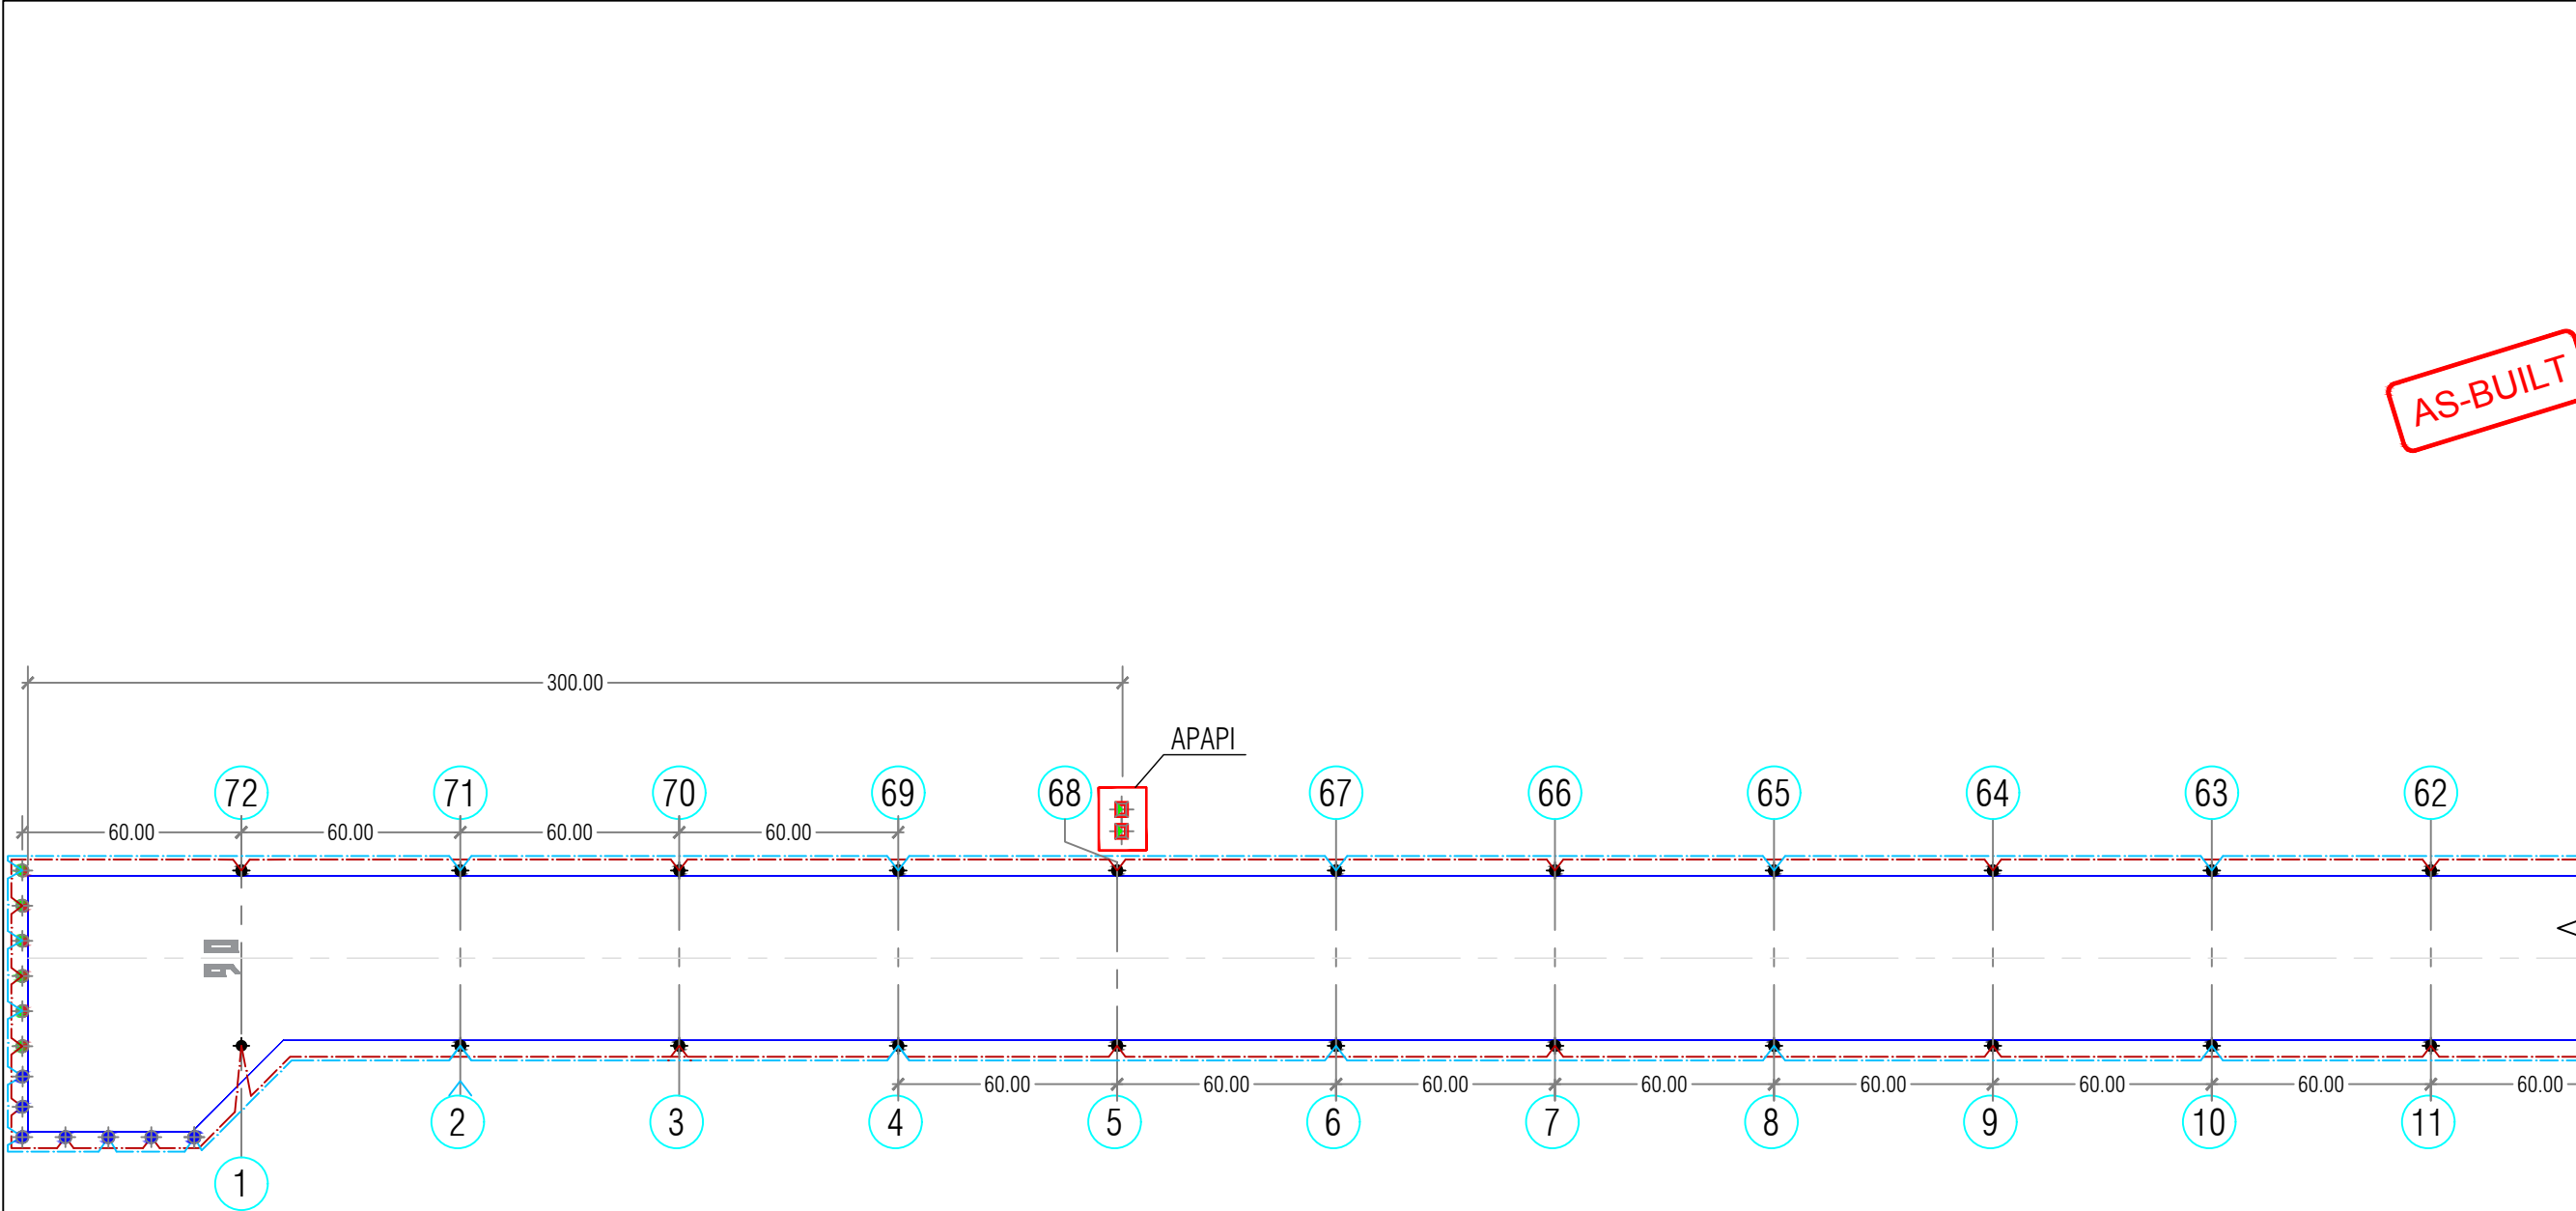

RUNWAY LIGHTING LAYOUT (GRID 1~12 AND 61~72)

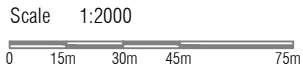

| SYMBOL | DESCRIPTION          | LOCATION                          |
|--------|----------------------|-----------------------------------|
|        | EDGE LIGHTS          | RUNWAY EDGE                       |
|        | EDGE LIGHTS          | TAXIWAY, APRON & TURNING PAD EDGE |
|        | END LIGHTS           | RUNWAY END                        |
|        | INSET LIGHTS         | RUNWAY (GRID-1)                   |
|        | FLOOD LIGHTS/ MAST   | APRON LANDSIDE EDGE               |
|        | APAPI                | 300M FROM RUNWAY PHYSICAL ENDS    |
|        | WIND CONE / WDI      | AS SHOWN                          |
|        | CONNECTION FROM CCR3 | AS SHOWN                          |
|        | CONNECTION FROM CCR2 | AS SHOWN                          |

KEY PLAN

M. PRABHU  
CONSULTANT SIGNATURE

19-08-2019  
DATE

APPROVAL OF REGIONAL AIRPORT  
MALDIVES

DATE

REFERENCE CONSTRUCTION DRAWING NUMBER

REV

T1713-TOS-33000-CV-DW-0002

A4

AS-BUILT

Description

Date

AS-BUILT

19/08/2019

DRAWING STATUS

APPROVED

REJECTED

N. MAAFARU AIRPORT

AIRFIELD LIGHTING &  
LANDING AIDS

Drawing Title:

RUNWAY LIGHTING LAYOUT  
GRID 1~12 AND 61~72

Employer:

REGIONAL AIRPORTS  
MINISTRY OF TOURISM

Funder:

صندوق أبوظبي للتنمية  
ABU DHABI FUND FOR DEVELOPMENT

Contractor:

TUFF

Consultant:

HOCHTIEF  
INDIA

Supervision & Management Consultant:

ARMSTRONG

Issue: AB


Date: AUG-2019

Pages: 02 of 38


Scale: N.T.S

Paper: A3

DWG #: T1713-TOS-33000-CV-DW-0002

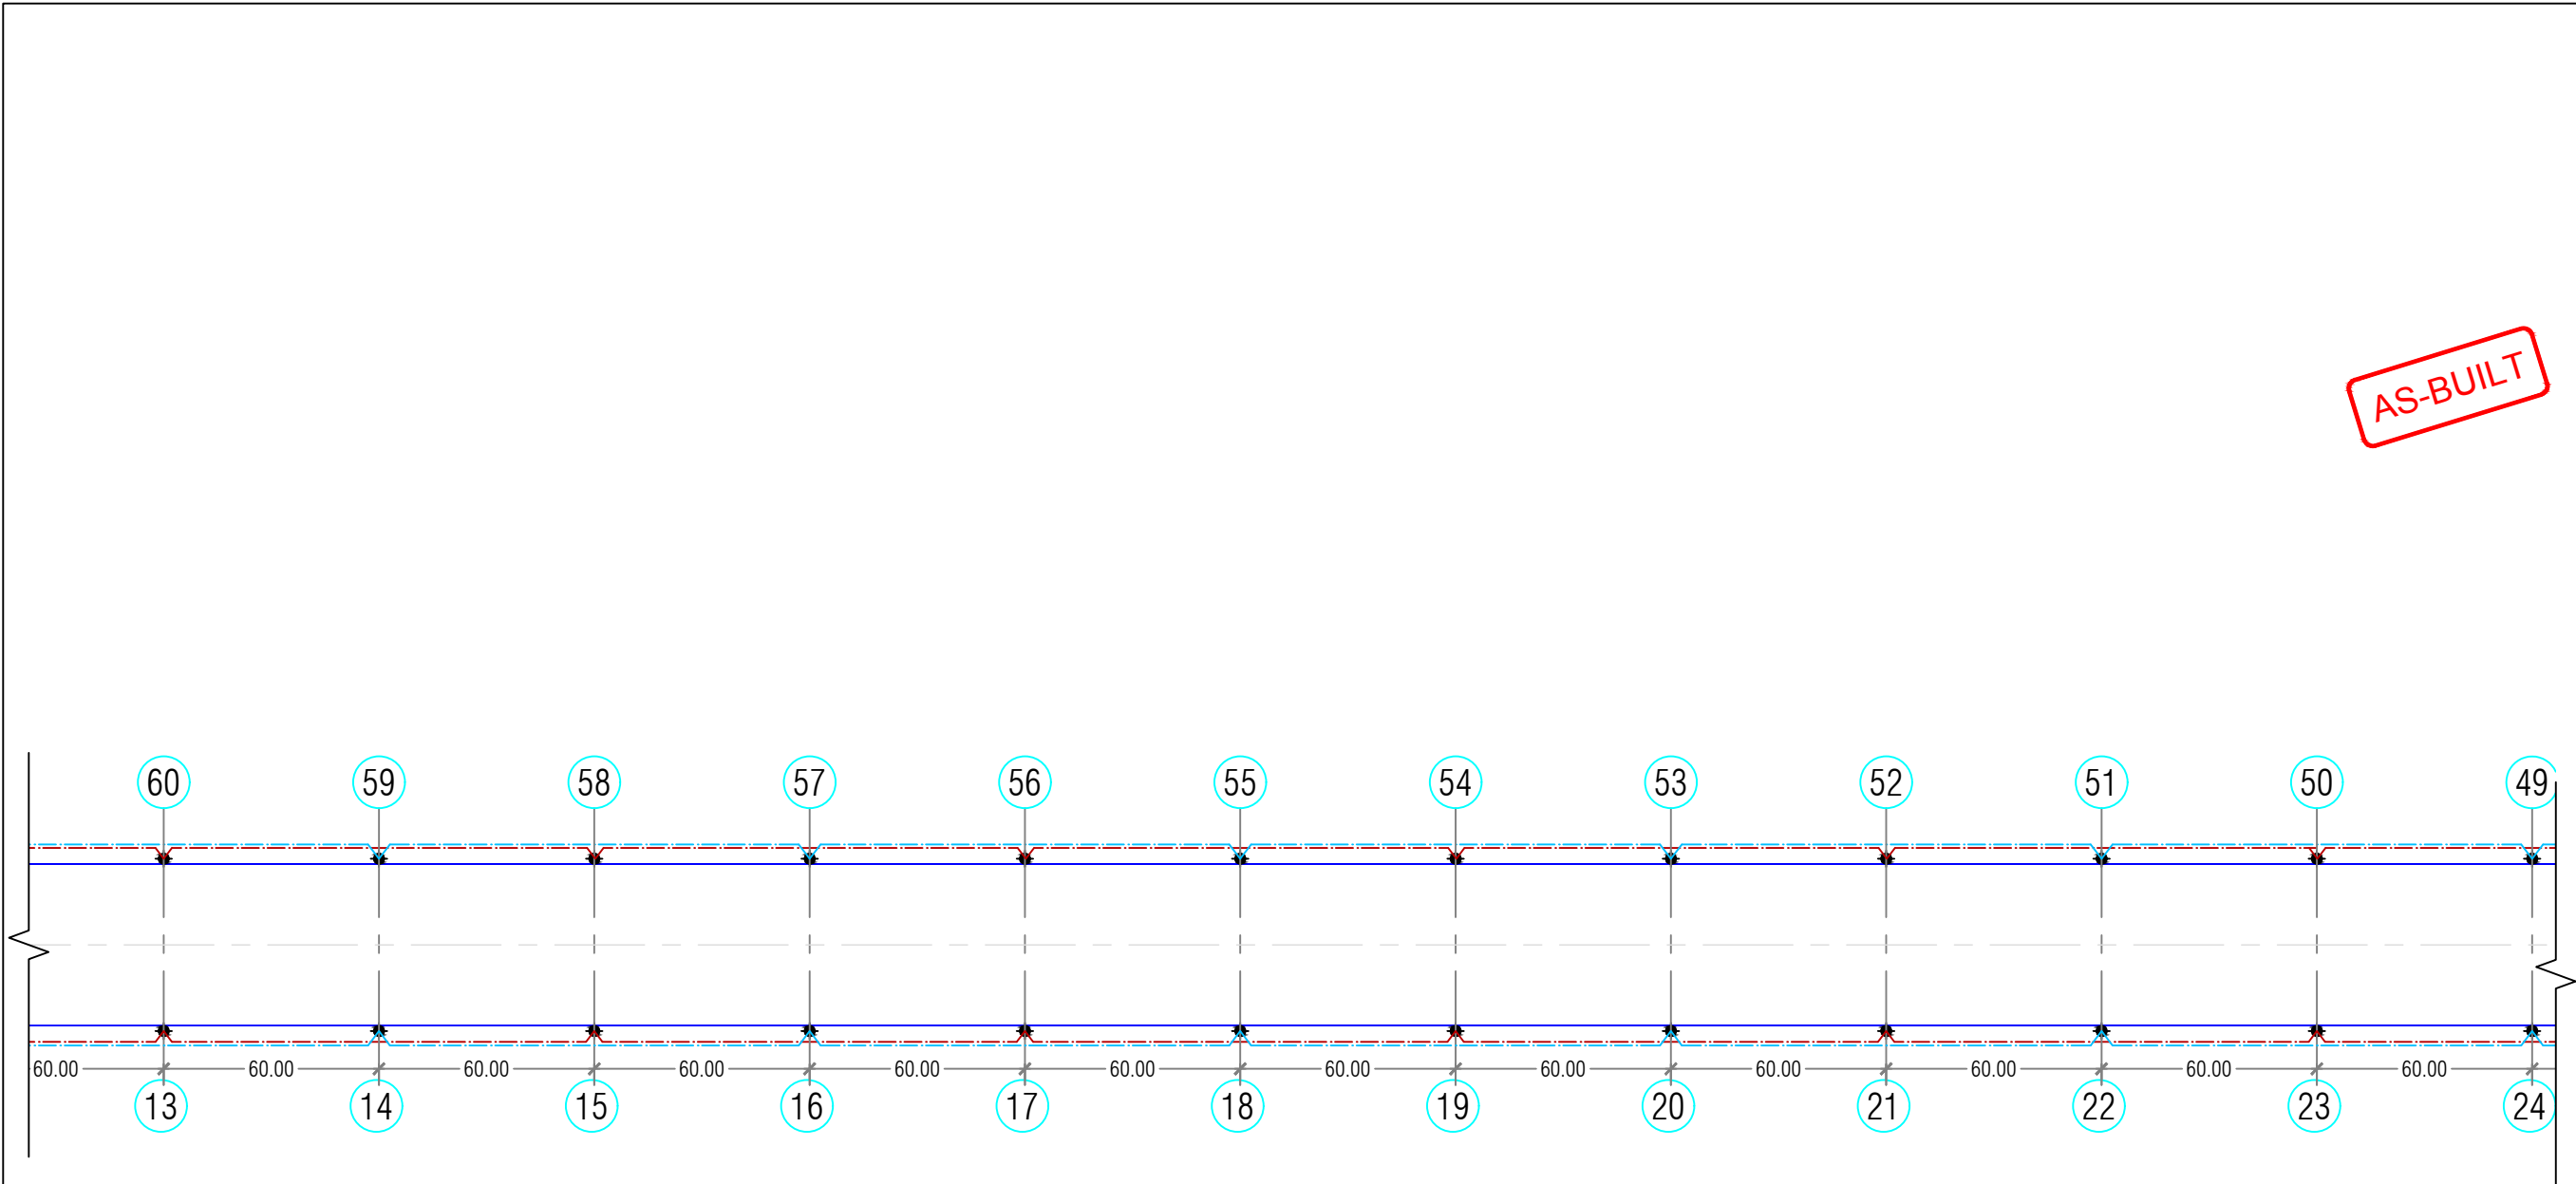

RUNWAY LIGHTING LAYOUT (GRID 13~24 AND 49~60)

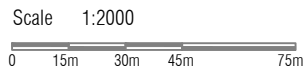

| SYMBOL | DESCRIPTION          | LOCATION                          |
|--------|----------------------|-----------------------------------|
|        | EDGE LIGHTS          | RUNWAY EDGE                       |
|        | EDGE LIGHTS          | TAXIWAY, APRON & TURNING PAD EDGE |
|        | END LIGHTS           | RUNWAY END                        |
|        | INSET LIGHTS         | RUNWAY (GRID-1)                   |
|        | FLOOD LIGHTS/ MAST   | APRON LANDSIDE EDGE               |
|        | APAPI                | 300M FROM RUNWAY PHYSICAL ENDS    |
|        | WIND CONE / WDI      | AS SHOWN                          |
|        | CONNECTION FROM CCR3 | AS SHOWN                          |
|        | CONNECTION FROM CCR2 | AS SHOWN                          |

KEY PLAN

M. PRABHU  
CONSULTANT SIGNATURE

19-08-2019  
DATE

APPROVAL OF REGIONAL AIRPORT  
MALDIVES

DATE

REFERENCE CONSTRUCTION DRAWING NUMBER

REV

T1713-TOS-33000-CV-DW-0003

A4

AS-BUILT

Description

Date

AS-BUILT

19/08/2019

DRAWING STATUS

APPROVED

REJECTED

N. MAAFARU AIRPORT

AIRFIELD LIGHTING &  
LANDING AIDS

Drawing Title:

RUNWAY LIGHTING LAYOUT  
GRID 13~24 AND 49~60

Employer:

REGIONAL AIRPORTS  
MINISTRY OF TOURISM

Funder:

صندوق أبوظبي للتنمية  
ABU DHABI FUND FOR DEVELOPMENT

Contractor:

Consultant:

Supervision & Management Consultant:

Issue: AB


Date: AUG-2019

Pages: 03 of 38

Scale: N.T.S

Paper: A3

DWG #: T1713-TOS-33000-CV-DW-0003

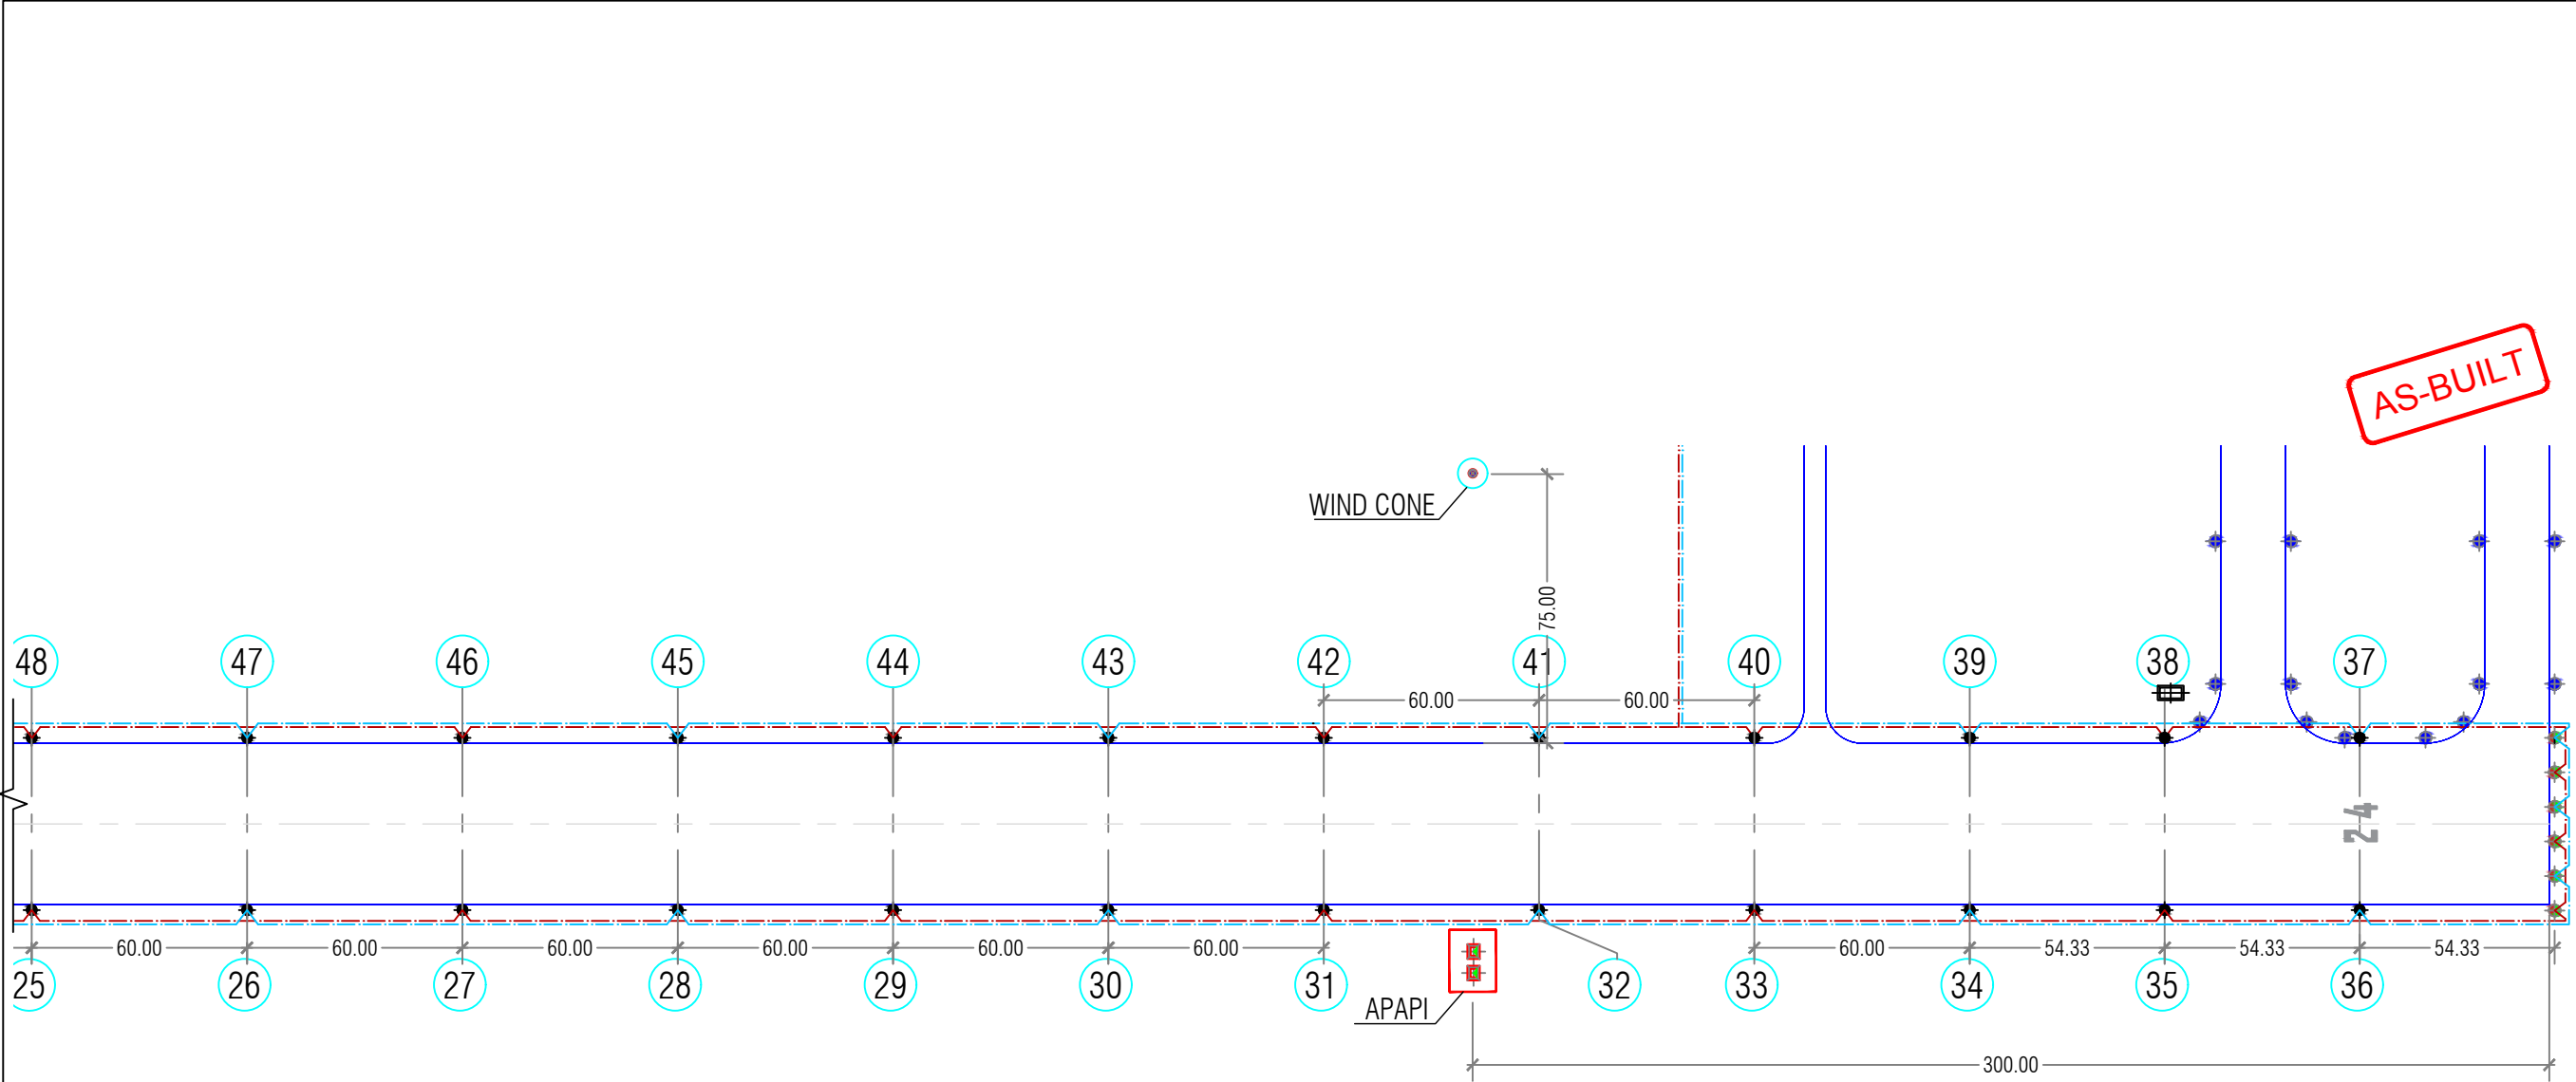

RUNWAY LIGHTING LAYOUT (GRID 25~48)



| SYMBOL | DESCRIPTION          | LOCATION                          |
|--------|----------------------|-----------------------------------|
|        | EDGE LIGHTS          | RUNWAY EDGE                       |
|        | EDGE LIGHTS          | TAXIWAY, APRON & TURNING PAD EDGE |
|        | END LIGHTS           | RUNWAY END                        |
|        | INSET LIGHTS         | RUNWAY (GRID-1)                   |
|        | FLOOD LIGHTS/ MAST   | APRON LANDSIDE EDGE               |
|        | APAPI                | 300M FROM RUNWAY PHYSICAL ENDS    |
|        | WIND CONE / WDI      | AS SHOWN                          |
|        | CONNECTION FROM CCR3 | AS SHOWN                          |
|        | CONNECTION FROM CCR2 | AS SHOWN                          |

KEY PLAN

M. PRABHU

CONSULTANT SIGNATURE

19-08-2019

DATE

APPROVAL OF REGIONAL AIRPORT

MALDIVES

DATE

REFERENCE CONSTRUCTION DRAWING NUMBER

T1713-TOS-33000-CV-DW-0004

REV

A4

AS-BUILT

Description

AS-BUILT

Date

19/08/2019

DRAWING STATUS

APPROVED

REJECTED

N. MAAFARU AIRPORT

AIRFIELD LIGHTING & LANDING AIDS

Drawing Title:

RUNWAY LIGHTING LAYOUT

GRID 25~48

Employer:

REGIONAL AIRPORTS

MINISTRY OF TOURISM

Funder:

صندوق أبوظبي للتنمية

ABU DHABI FUND FOR DEVELOPMENT

Contractor:

TUFF

Consultant:

HOCHTIEF

INDIA

Supervision & Management Consultant:

ARMSTRONG

Issue:

AB

Date:

AUG-2019

Pages:

04 of 38

Scale:

N.T.S

Paper:


A3

DWG #:

T1713-TOS-33000-CV-DW-0004





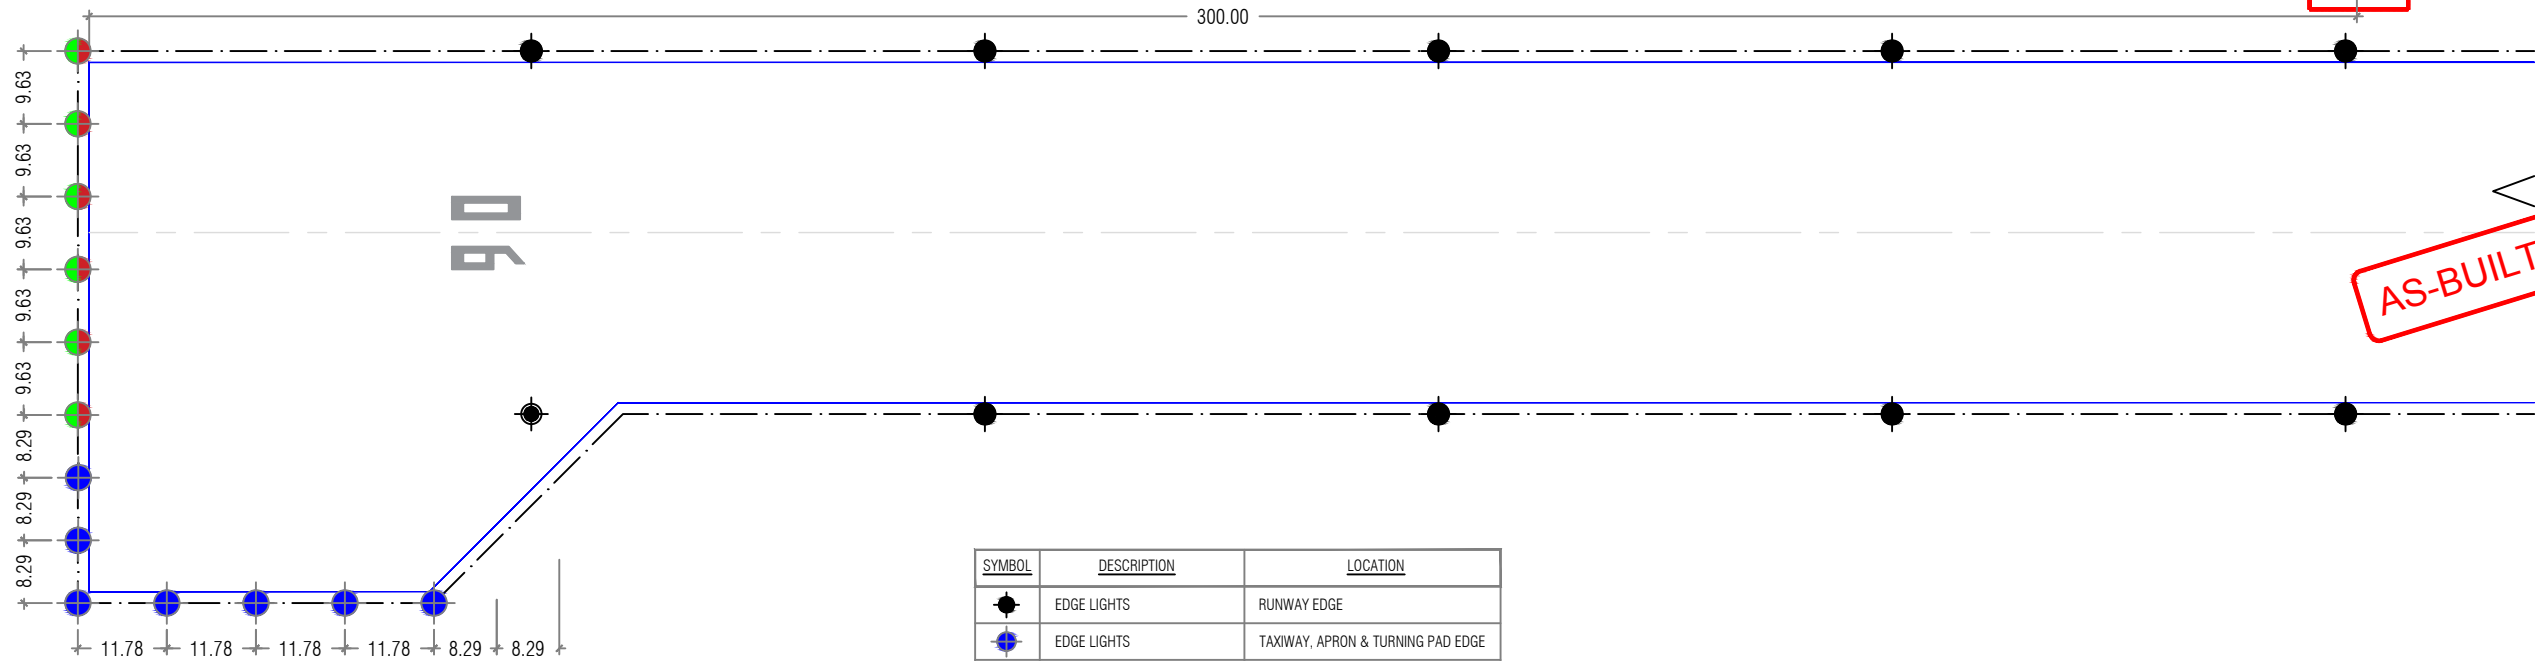


RUNWAY END DETAIL (06 END)

Scale 1:1000





| SYMBOL | DESCRIPTION          | LOCATION                          |
|--------|----------------------|-----------------------------------|
|        | EDGE LIGHTS          | RUNWAY EDGE                       |
|        | EDGE LIGHTS          | TAXIWAY, APRON & TURNING PAD EDGE |
|        | END LIGHTS           | RUNWAY END                        |
|        | INSET LIGHTS         | RUNWAY (GRID-1)                   |
|        | FLOOD LIGHTS/ MAST   | APRON LANDSIDE EDGE               |
|        | APAPI                | 300M FROM RUNWAY PHYSICAL ENDS    |
|        | WIND CONE / WDI      | AS SHOWN                          |
|        | CONNECTION FROM CCR3 | AS SHOWN                          |

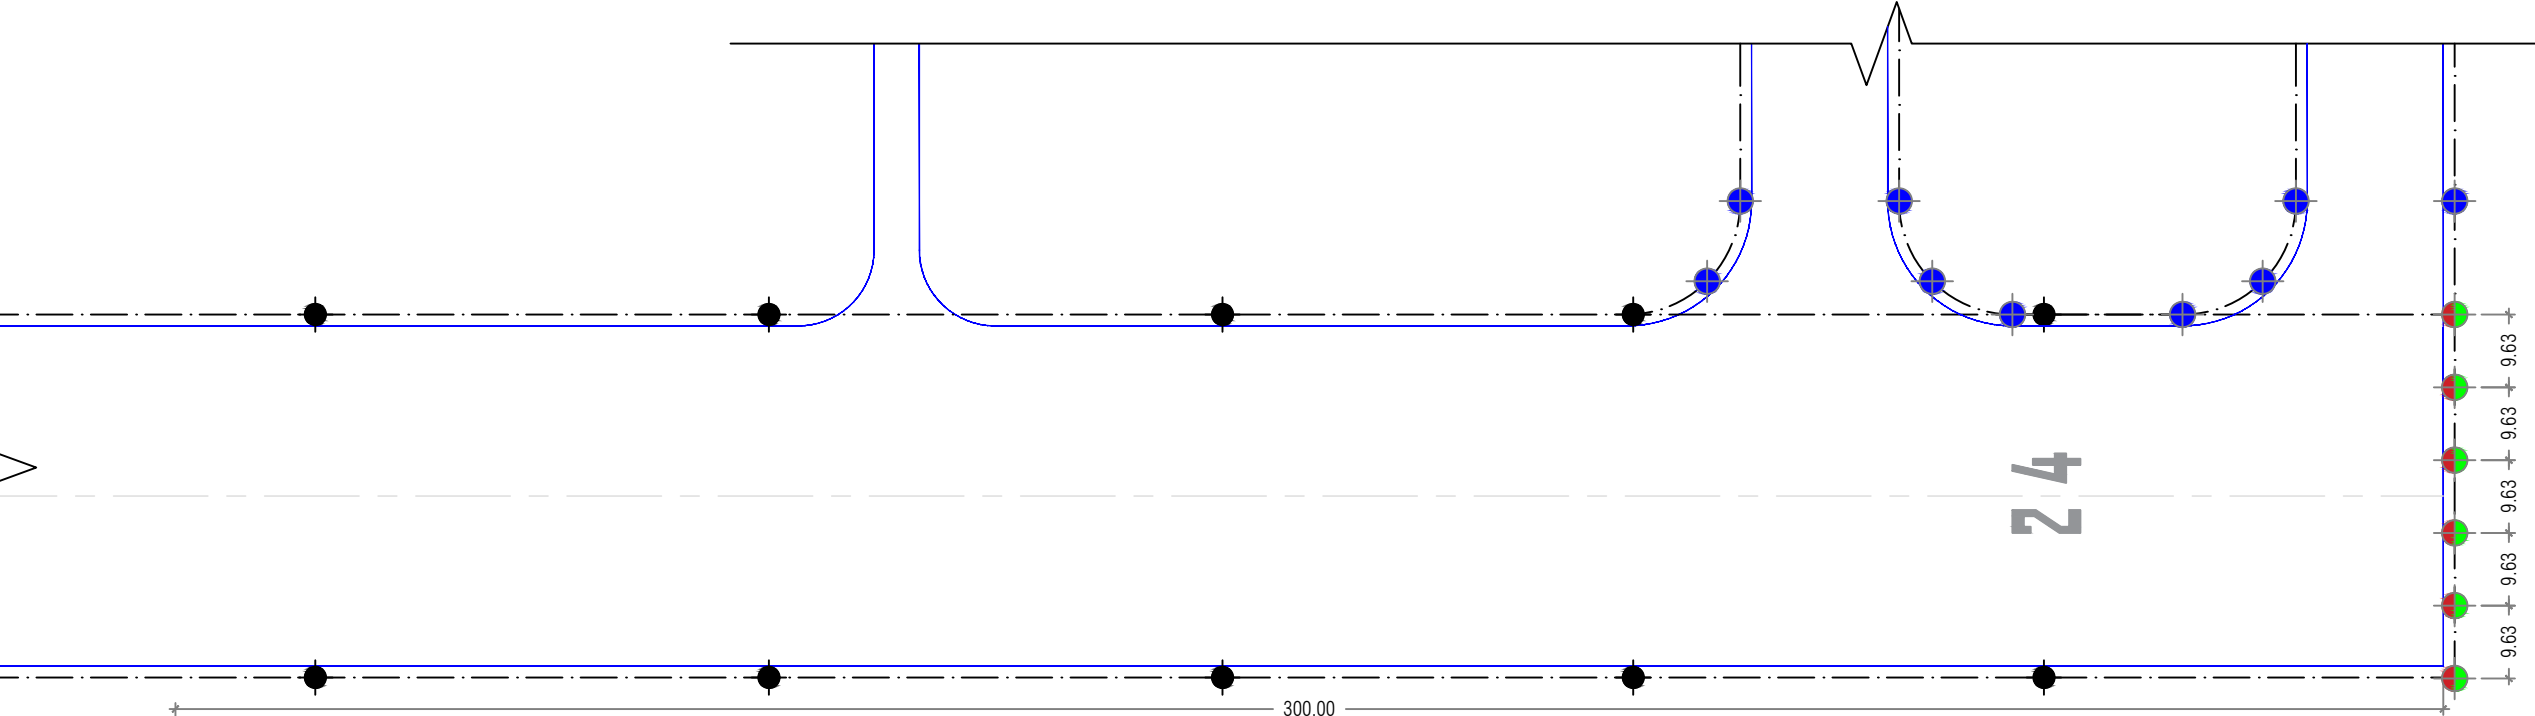

RUNWAY END DETAIL (24 END)

 Scale 1:1000

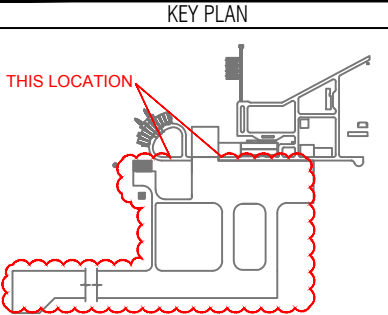

19-08-2019  
M. PRABHU  
CONSULTANT SIGNATURE  
DATE

APPROVAL OF REGIONAL AIRPORT  
MALDIVES  
DATE

REFERENCE CONSTRUCTION DRAWING NUMBER  
T1713-TOS-33000-CV-DW-0006  
REV  
A4

AS-BUILT  
Description  
Date  
AS-BUILT  
19/08/2019

DRAWING STATUS  
APPROVED  
REJECTED

N. MAAFARU AIRPORT  
AIRFIELD LIGHTING &  
LANDING AIDS

Drawing Title:  
RUNWAY END LIGHT DETAILS  
06 & 24 END

Employer:  
REGIONAL AIRPORTS  
MINISTRY OF TOURISM

Funder:  
  
صندوق أبوظبي للتنمية  
ABU DHABI FUND FOR DEVELOPMENT

Contractor:  
  
TUFF


Consultant:  
  
HOCHTIEF  
INDIA

Supervision & Management Consultant:  
  
ARMSTRONG

Issue: AB  
Date: AUG-2019  
Pages: 06 of 38

Scale: N.T.S.  
Paper: A3

DWG #: T1713-TOS-33000-CV-DW-0006


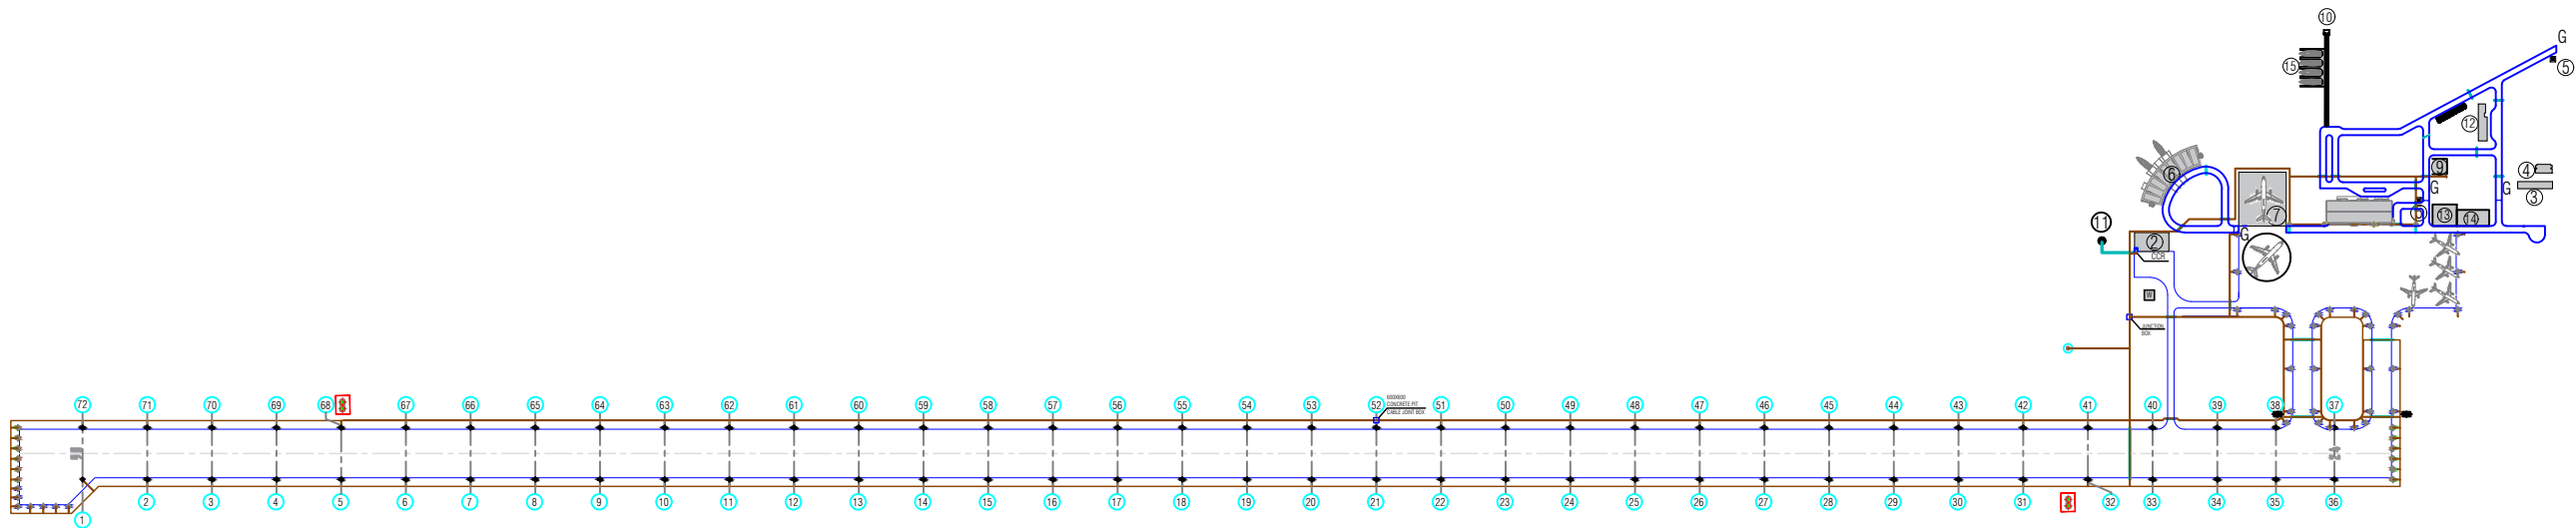


### CABLE TRENCH LAYOUT

Scale 1:7000



| SYMBOL | DESCRIPTION                      | SIZE        | LENGTH |
|--------|----------------------------------|-------------|--------|
|        | CABLE TRENCH 8M FROM RUNWAY EDGE | 600 MM WIDE | 7218M  |
|        | SERVICE DUCT                     | -           | -      |

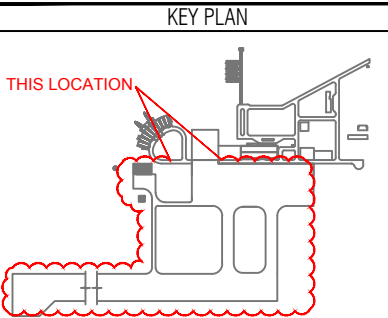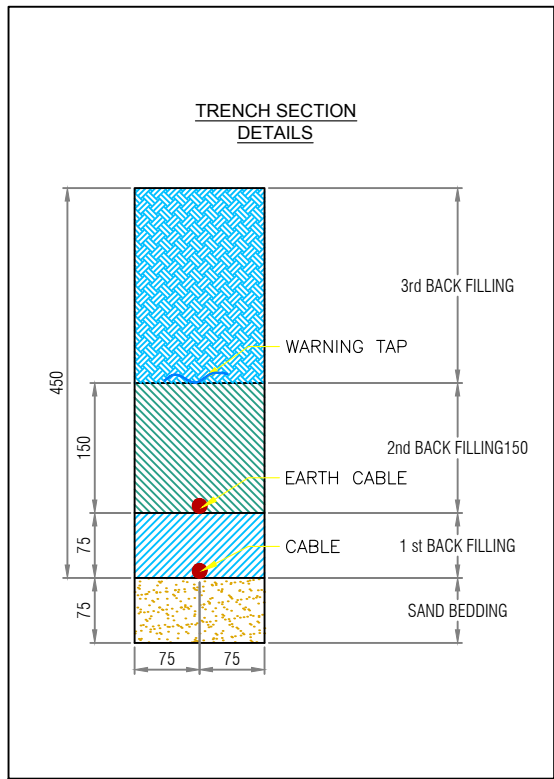

|                              |      |
|------------------------------|------|
| 19-08-2019                   |      |
| M. PRABHU                    | DATE |
| CONSULTANT SIGNATURE         |      |
| APPROVAL OF REGIONAL AIRPORT |      |
| MALDIVES                     | DATE |

| REFERENCE CONSTRUCTION DRAWING NUMBER | REV |
|---------------------------------------|-----|
| T1713-TOS-33000-CV-DW-0007            | A4  |

| AS-BUILT    |            |
|-------------|------------|
| Description | Date       |
| AS-BUILT    | 19/08/2019 |

DRAWING STATUS ☒ APPROVED ☐ REJECTED

### N. MAAFARU AIRPORT

#### AIRFIELD LIGHTING & LANDING AIDS

Drawing Title:

CABLE TRENCH LAYOUT

Employer:

REGIONAL AIRPORTS

MINISTRY OF TOURISM

Funder:



صندوق أبوظبي للتنمية

ABU DHABI FUND FOR DEVELOPMENT

Contractor:



Consultant:




Supervision & Management Consultant:



|           |                |                 |
|-----------|----------------|-----------------|
| Issue: AB | Date: AUG-2019 | Pages: 07 of 38 |
|-----------|----------------|-----------------|


|              |           |
|--------------|-----------|
| Scale: N.T.S | Paper: A3 |
|--------------|-----------|

DWG #: T1713-TOS-33000-CV-DW-0007

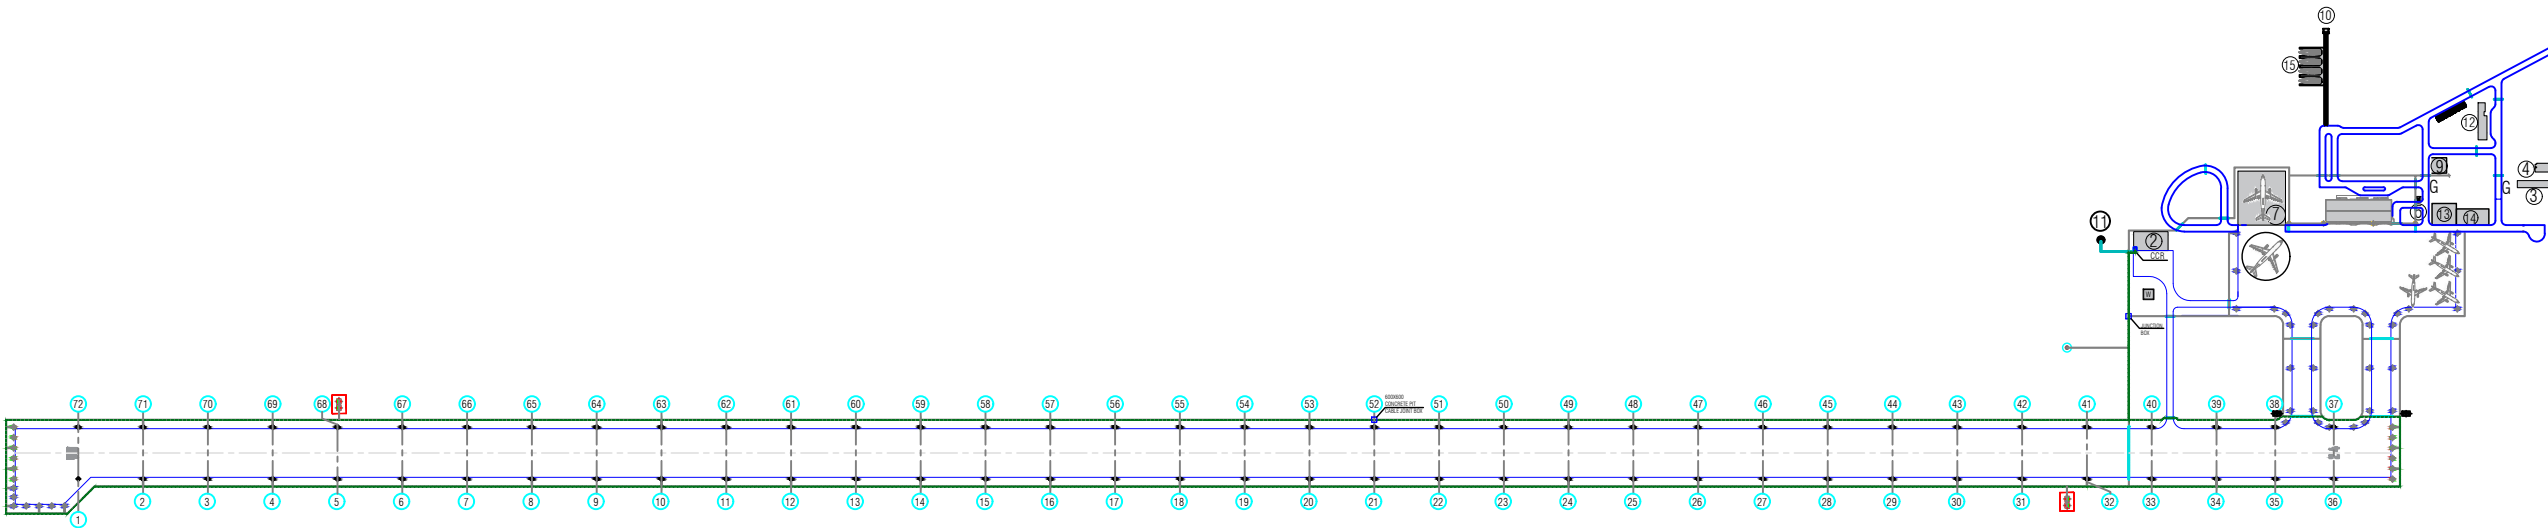


AGL CABLE - A (PRIMARY & SECONDARY) LAYOUT

Scale 1:7000

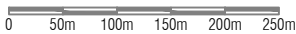

| SYMBOL | DESCRIPTION  | SIZE                          |
|--------|--|-------------------------------|
|        | AGL PRIMARY CABLE - A (CIRCUIT WRE 1 CONNECTED TO CCR 1) | 6MM <sup>2</sup> ( 1 CORE)    |
|        | AGL SECONDARY CABLE - A                                  | 2.5 MM <sup>2</sup> ( 2 CORE) |
|        | SERVICE DUCT   | -                             |

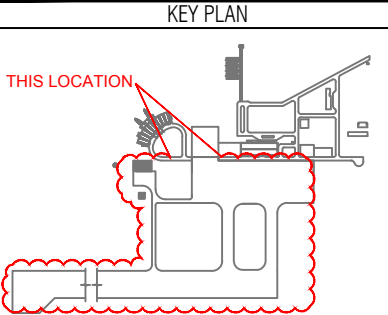

|                              |      |
|------------------------------|------|
| 19-08-2019                   |      |
| M. PRABHU                    | DATE |
| CONSULTANT SIGNATURE         |      |
| APPROVAL OF REGIONAL AIRPORT |      |
| MALDIVES                     | DATE |

| REFERENCE CONSTRUCTION DRAWING NUMBER | REV |
|---------------------------------------|-----|
| T1713-TOS-33000-CV-DW-0008            | A4  |

| AS-BUILT    |            |
|-------------|------------|
| Description | Date       |
| AS-BUILT    | 19/08/2019 |

DRAWING STATUS ☒ APPROVED ☐ REJECTED

**N. MAAFARU AIRPORT**  
AIRFIELD LIGHTING & LANDING AIDS

Drawing Title:  
AGL CABLE - A (PRIMARY & SECONDARY) LAYOUT

Employer:  
**REGIONAL AIRPORTS**  
MINISTRY OF TOURISM


Funder:  
  
صندوق أبوظبي للتنمية  
ABU DHABI FUND FOR DEVELOPMENT

Contractor:  
 **TUFF**

Consultant:  
 **HOCHTIEF**  
INDIA

Supervision & Management Consultant:  
 **ARMSTRONG**

|                                   |                |                 |
|-----------------------------------|----------------|-----------------|
| Issue: AB                         | Date: AUG-2019 | Pages: 08 of 38 |
| Scale: N.T.S                      |                | Paper: A3       |
| DWG #: T1713-TOS-33000-CV-DW-0008 |                |                 |

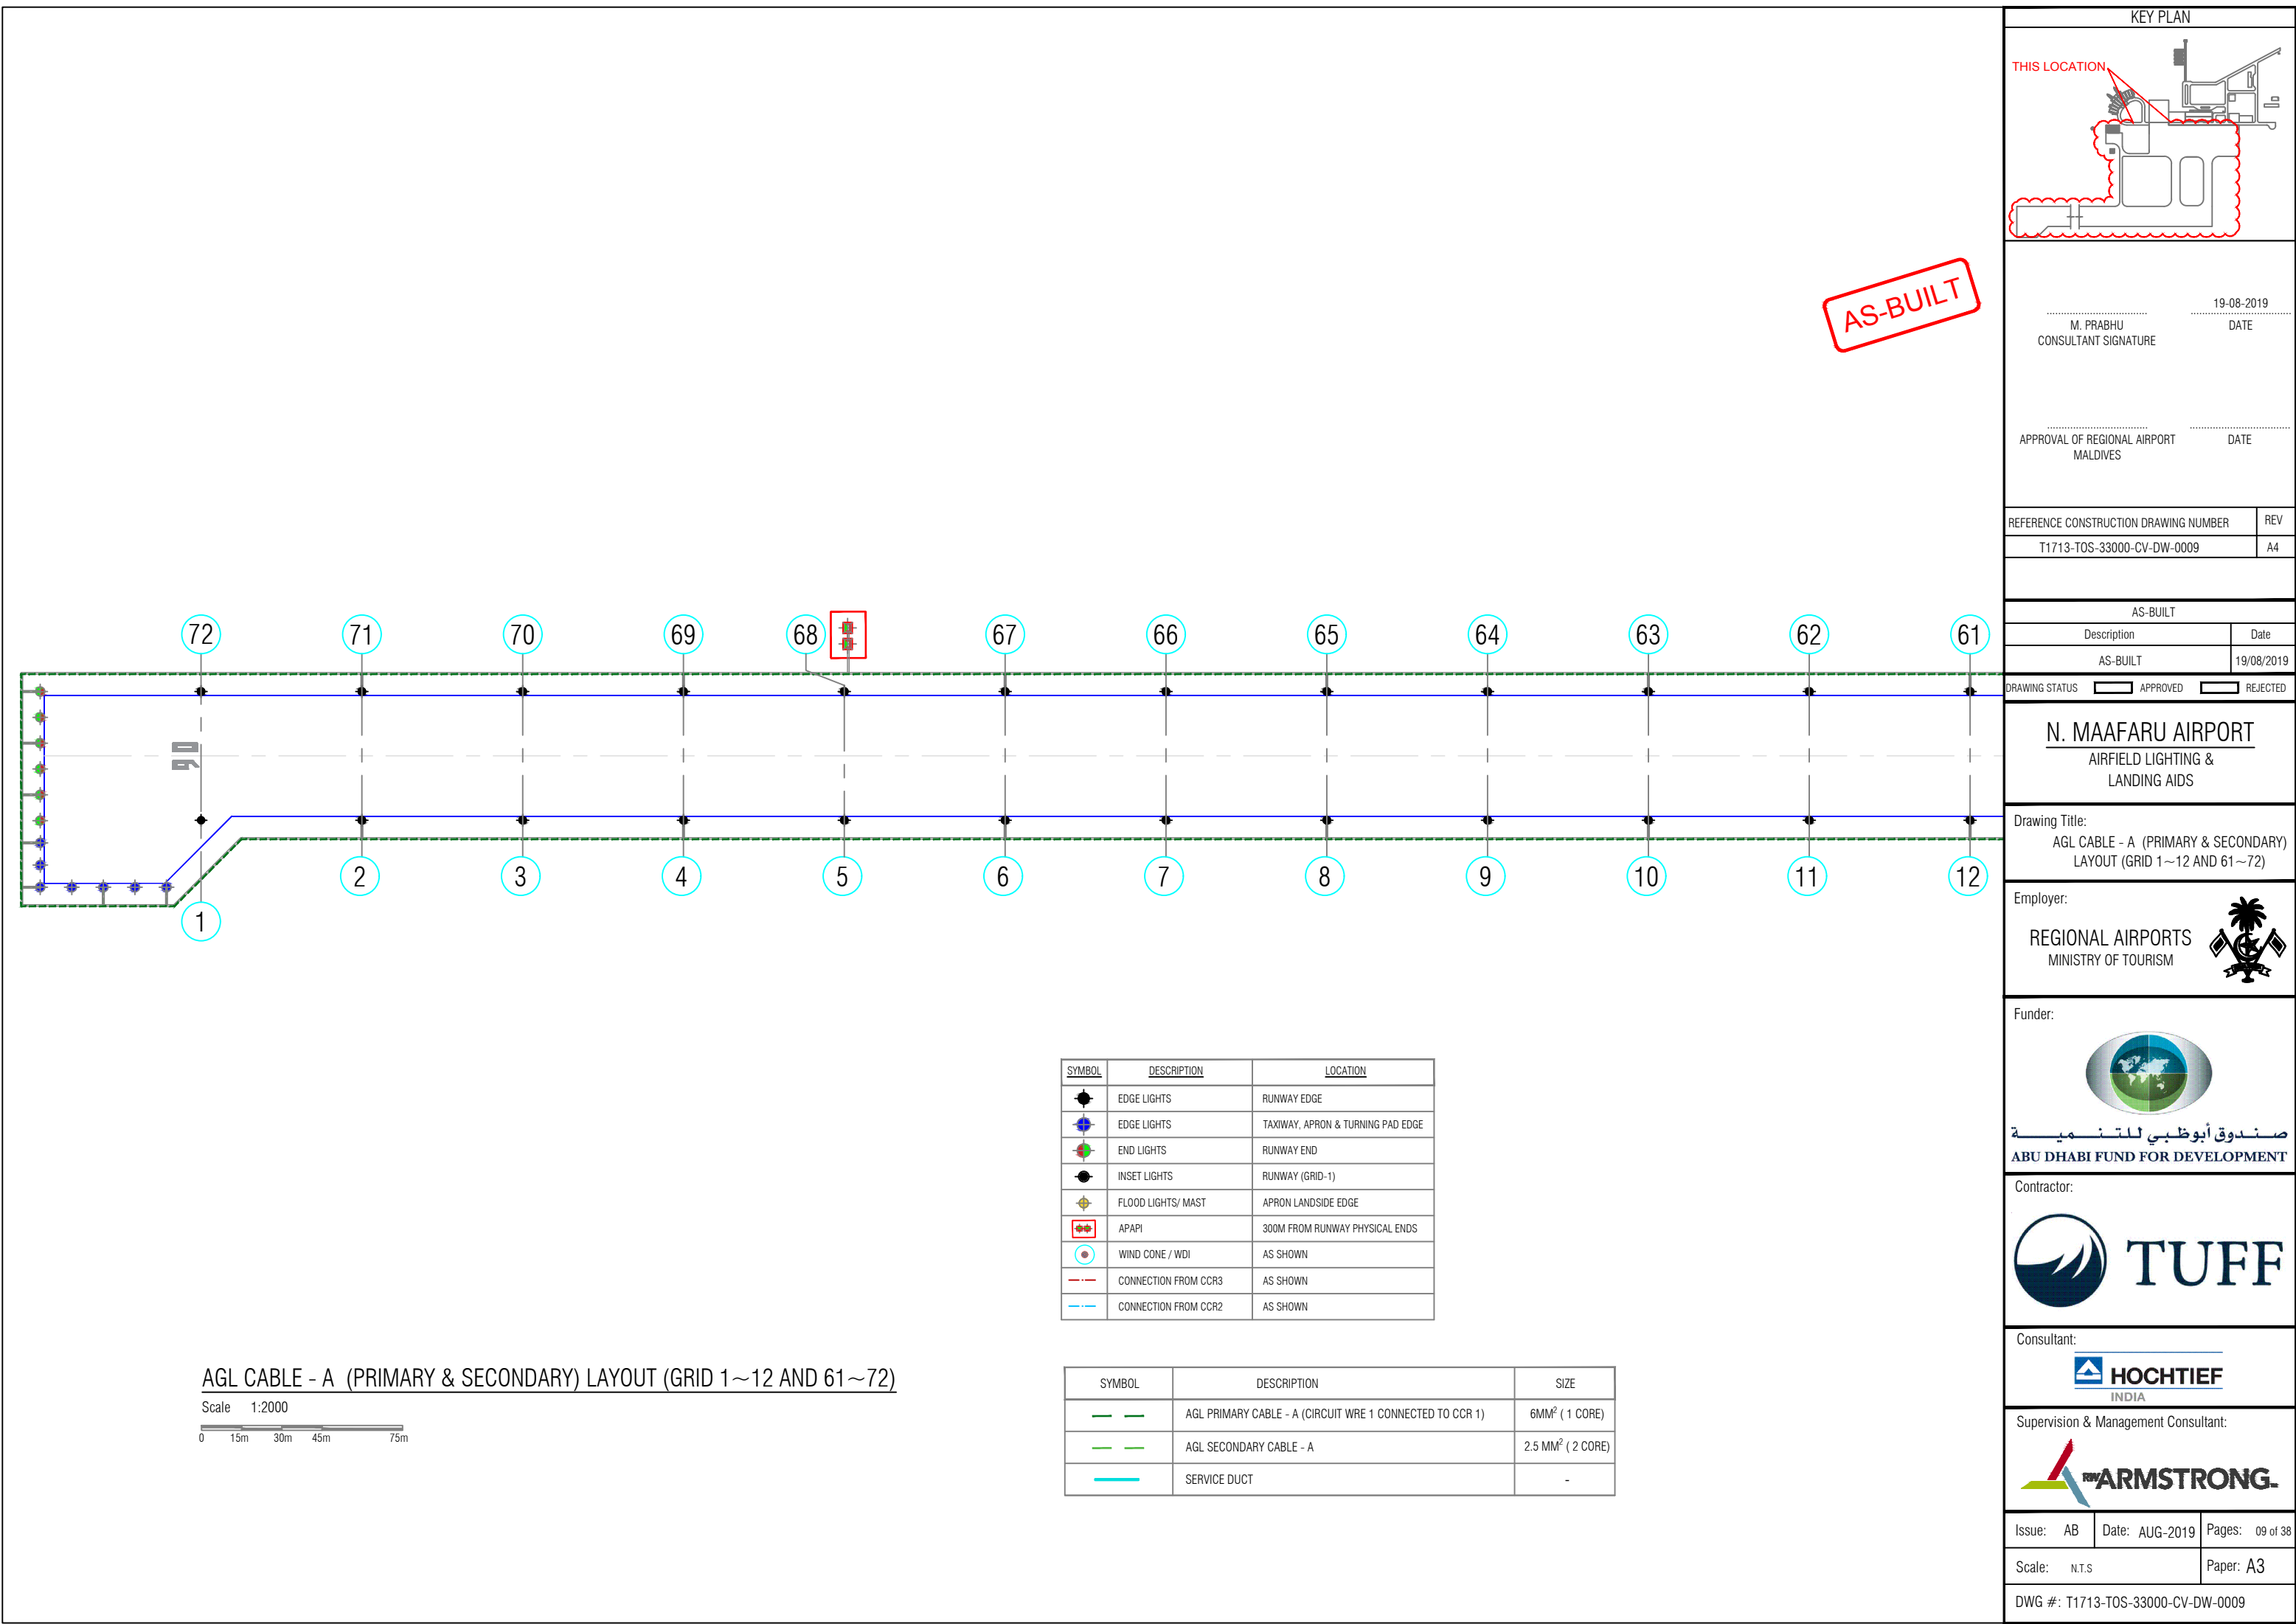

KEY PLAN

M. PRABHU  
CONSULTANT SIGNATURE

19-08-2019  
DATE

APPROVAL OF REGIONAL AIRPORT  
MALDIVES

DATE

REFERENCE CONSTRUCTION DRAWING NUMBER

REV

T1713-TOS-33000-CV-DW-0009

A4

AS-BUILT

Description

Date

AS-BUILT

19/08/2019

DRAWING STATUS

☒ APPROVED

☐ REJECTED

N. MAAFARU AIRPORT

AIRFIELD LIGHTING & LANDING AIDS

Drawing Title:

AGL CABLE - A (PRIMARY & SECONDARY) LAYOUT (GRID 1~12 AND 61~72)

Employer:

REGIONAL AIRPORTS  
MINISTRY OF TOURISM

Funder:

صندوق أبوظبي للتنمية  
ABU DHABI FUND FOR DEVELOPMENT

Contractor:

TUFF

Consultant:

HOCHTIEF  
INDIA

Supervision & Management Consultant:

ARMSTRONG

Issue: AB

Date: AUG-2019

Pages: 09 of 38

Scale: N.T.S

Paper: A3


DWG #: T1713-TOS-33000-CV-DW-0009

AGL CABLE - A (PRIMARY & SECONDARY) LAYOUT (GRID 1~12 AND 61~72)




| SYMBOL | DESCRIPTION          | LOCATION                          |
|--------|----------------------|-----------------------------------|
|        | EDGE LIGHTS          | RUNWAY EDGE                       |
|        | EDGE LIGHTS          | TAXIWAY, APRON & TURNING PAD EDGE |
|        | END LIGHTS           | RUNWAY END                        |
|        | INSET LIGHTS         | RUNWAY (GRID-1)                   |
|        | FLOOD LIGHTS/ MAST   | APRON LANDSIDE EDGE               |
|        | APAPI                | 300M FROM RUNWAY PHYSICAL ENDS    |
|        | WIND CONE / WDI      | AS SHOWN                          |
|        | CONNECTION FROM CCR3 | AS SHOWN                          |
|        | CONNECTION FROM CCR2 | AS SHOWN                          |

| SYMBOL | DESCRIPTION  | SIZE                          |
|--------|--|-------------------------------|
|        | AGL PRIMARY CABLE - A (CIRCUIT WRE 1 CONNECTED TO CCR 1) | 6MM <sup>2</sup> ( 1 CORE)    |
|        | AGL SECONDARY CABLE - A                                  | 2.5 MM <sup>2</sup> ( 2 CORE) |
|        | SERVICE DUCT   | -                             |

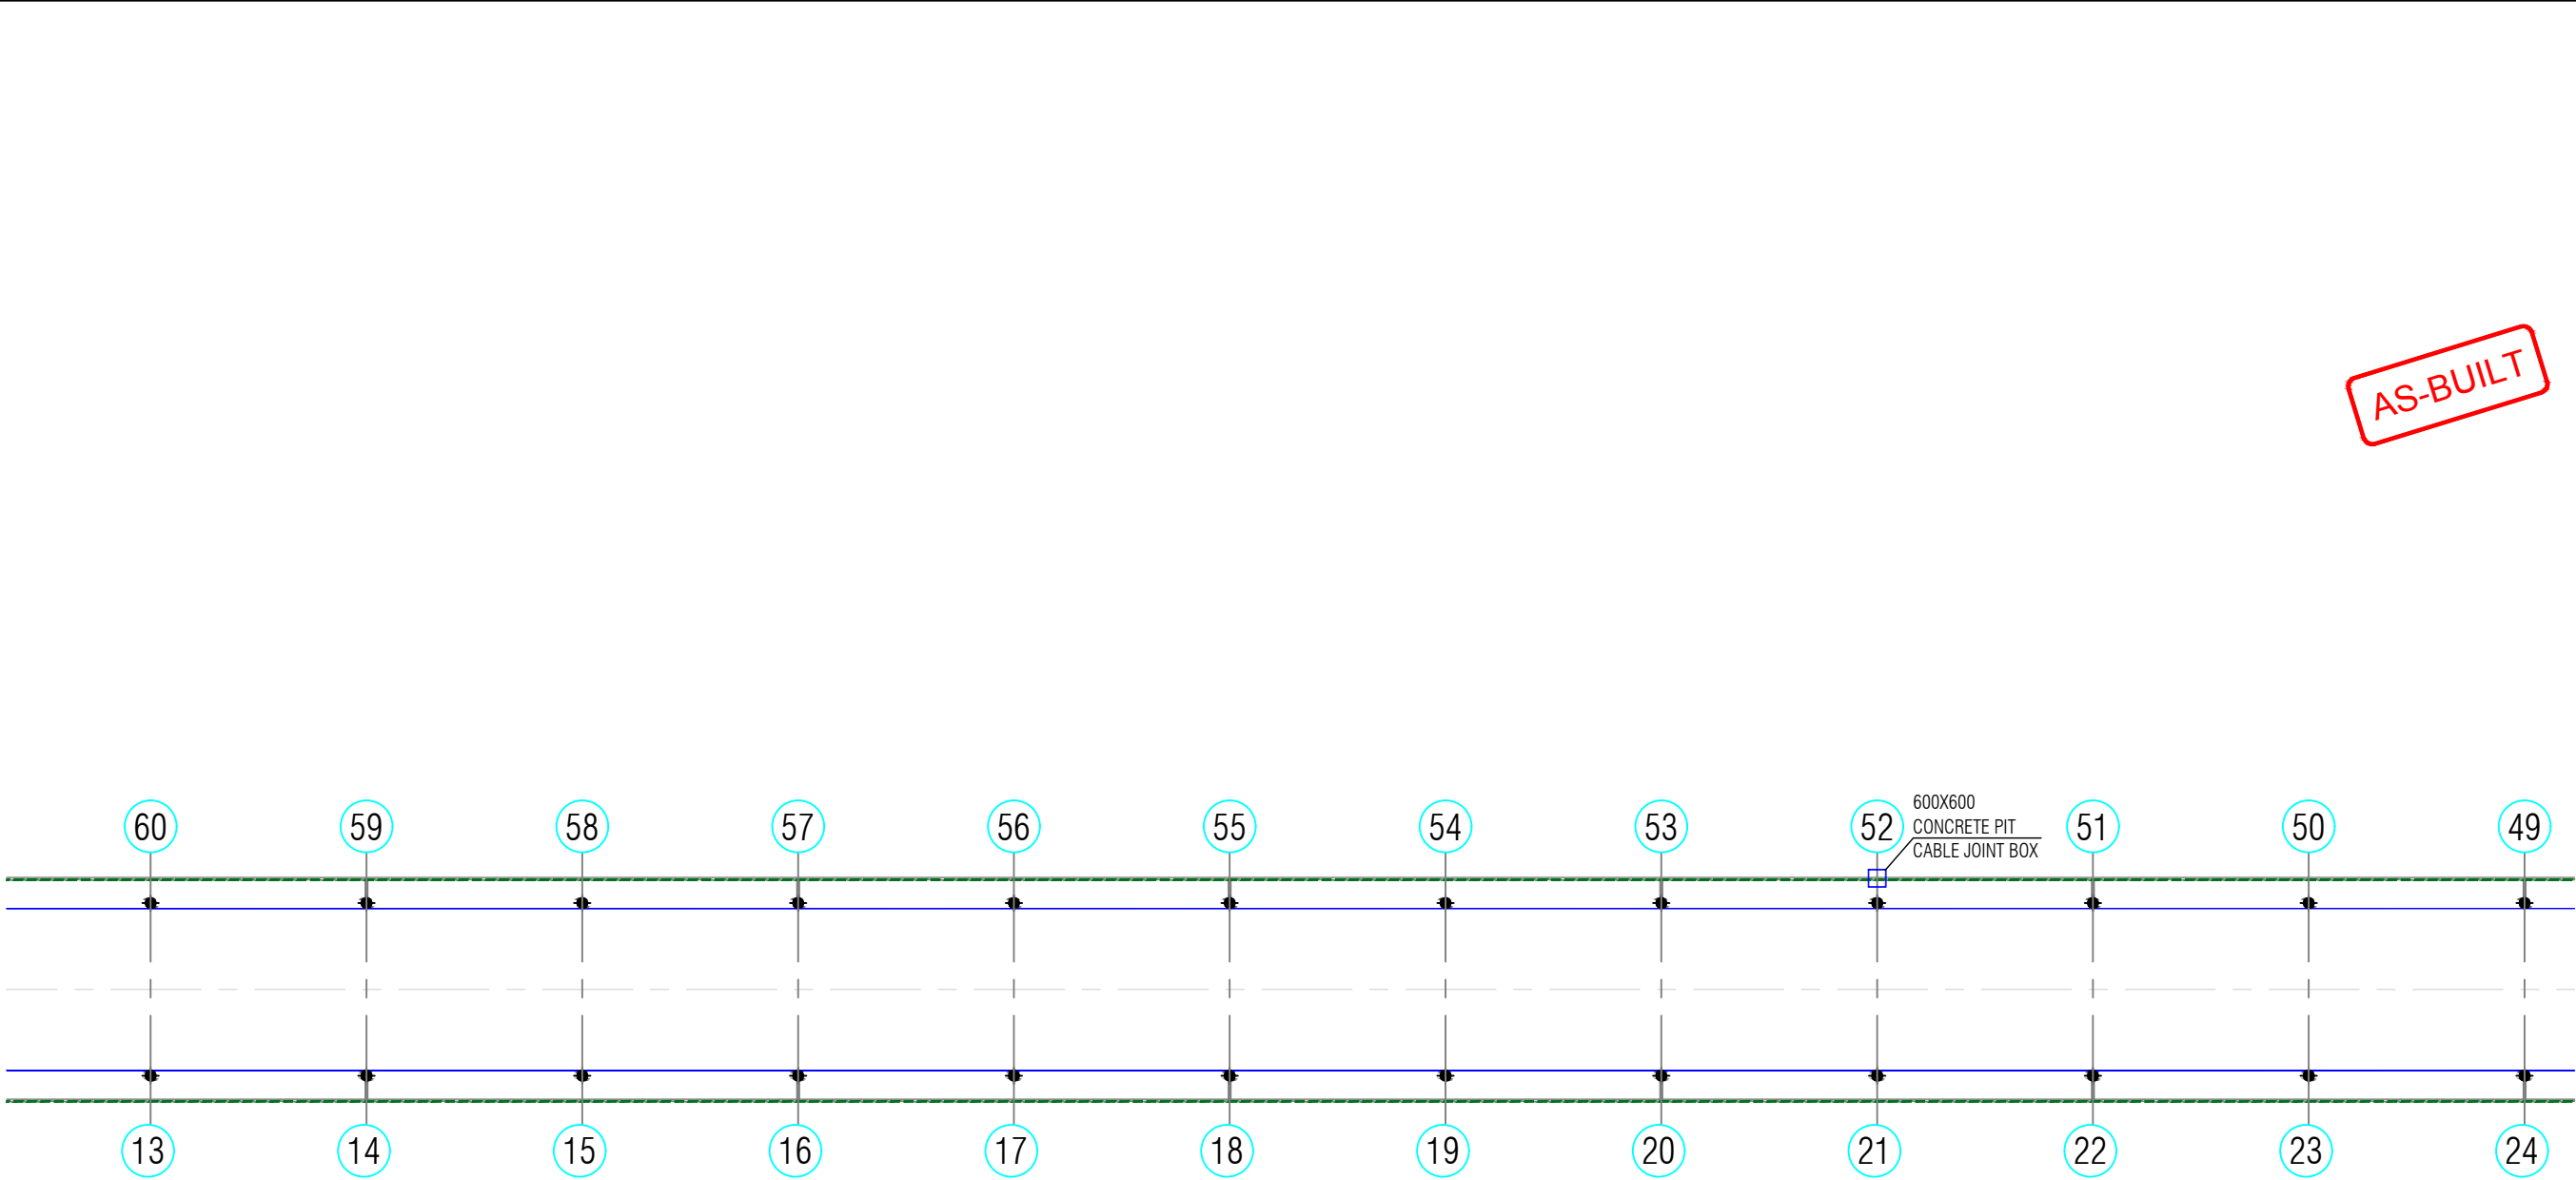


AGL CABLE - A (PRIMARY & SECONDARY) LAYOUT (GRID 13~24 AND 49~60)

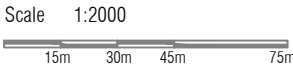

| SYMBOL | DESCRIPTION          | LOCATION                          |
|--------|----------------------|-----------------------------------|
|        | EDGE LIGHTS          | RUNWAY EDGE                       |
|        | EDGE LIGHTS          | TAXIWAY, APRON & TURNING PAD EDGE |
|        | END LIGHTS           | RUNWAY END                        |
|        | INSET LIGHTS         | RUNWAY (GRID-1)                   |
|        | FLOOD LIGHTS/ MAST   | APRON LANDSIDE EDGE               |
|        | APAPI                | 300M FROM RUNWAY PHYSICAL ENDS    |
|        | WIND CONE / WDI      | AS SHOWN                          |
|        | CONNECTION FROM CCR3 | AS SHOWN                          |
|        | CONNECTION FROM CCR2 | AS SHOWN                          |

| SYMBOL | DESCRIPTION  | SIZE                          |
|--------|--|-------------------------------|
|        | AGL PRIMARY CABLE - A (CIRCUIT WRE 1 CONNECTED TO CCR 1) | 6MM <sup>2</sup> ( 1 CORE)    |
|        | AGL SECONDARY CABLE - A                                  | 2.5 MM <sup>2</sup> ( 2 CORE) |
|        | SERVICE DUCT   | -                             |

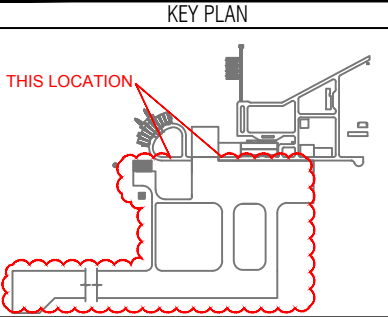

M. PRABHU

CONSULTANT SIGNATURE

19-08-2019

DATE

APPROVAL OF REGIONAL AIRPORT

MALDIVES

DATE

| REFERENCE CONSTRUCTION DRAWING NUMBER | REV |
|---------------------------------------|-----|
| T1713-TOS-33000-CV-DW-0010            | A4  |

| AS-BUILT    |            |
|-------------|------------|
| Description | Date       |
| AS-BUILT    | 19/08/2019 |

DRAWING STATUS ☒ APPROVED ☐ REJECTED

**N. MAAFARU AIRPORT**  
AIRFIELD LIGHTING & LANDING AIDS

Drawing Title:  
AGL CABLE - A (PRIMARY & SECONDARY)  
LAYOUT (GRID 13~24 AND 49~60)


Employer:  
**REGIONAL AIRPORTS**  
MINISTRY OF TOURISM

Funder:  
  
**صندوق أبوظبي للتنمية**  
**ABU DHABI FUND FOR DEVELOPMENT**

Contractor:  
  
**TUFF**

Consultant:  
  
**HOCHTIEF**  
INDIA

Supervision & Management Consultant:  
  
**ARMSTRONG**

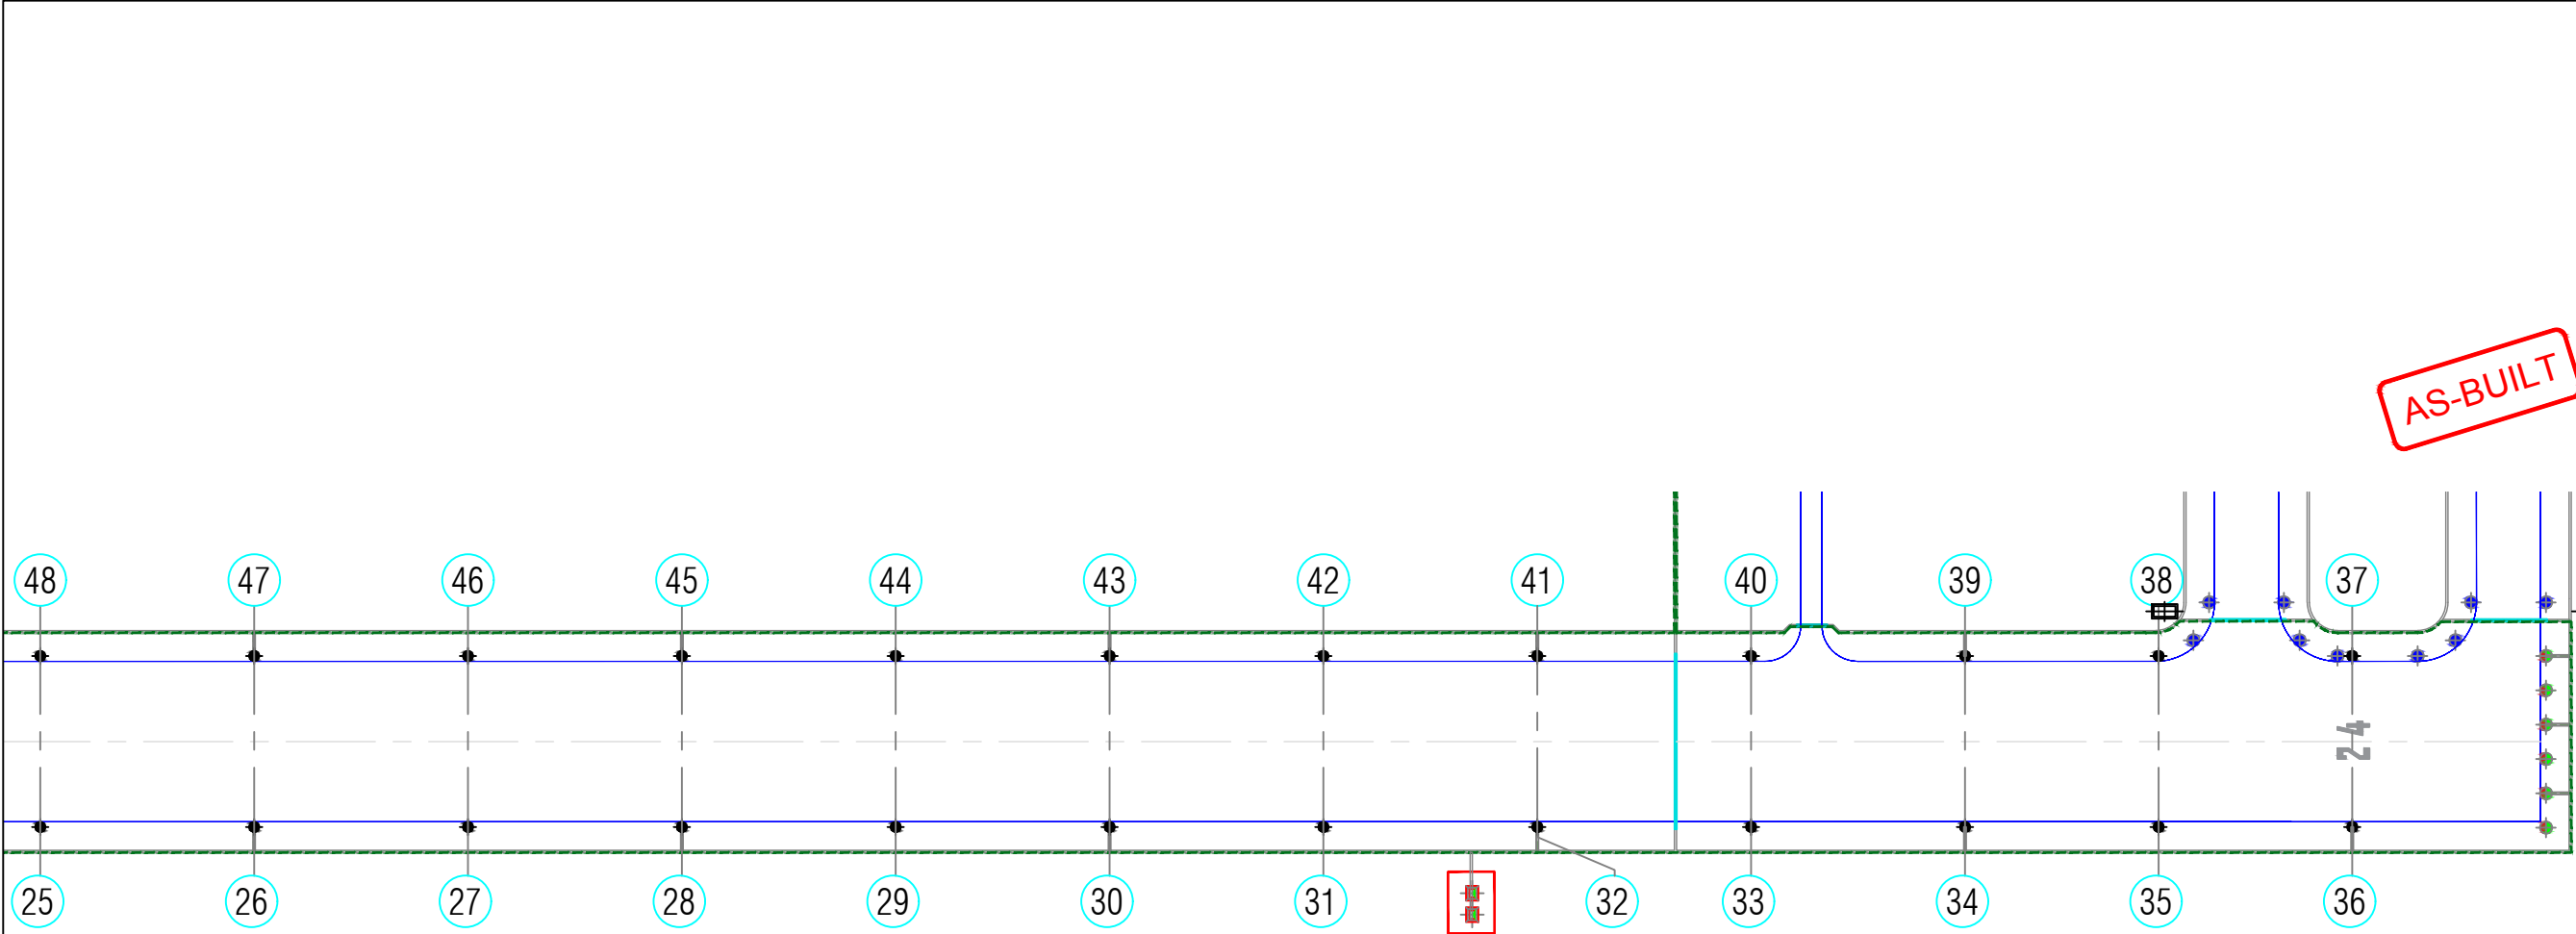

AGL CABLE - A (PRIMARY & SECONDARY) LAYOUT (GRID 25~48)



| SYMBOL | DESCRIPTION          | LOCATION                          |
|--------|----------------------|-----------------------------------|
|        | EDGE LIGHTS          | RUNWAY EDGE                       |
|        | EDGE LIGHTS          | TAXIWAY, APRON & TURNING PAD EDGE |
|        | END LIGHTS           | RUNWAY END                        |
|        | INSET LIGHTS         | RUNWAY (GRID-1)                   |
|        | FLOOD LIGHTS/ MAST   | APRON LANDSIDE EDGE               |
|        | APAPI                | 300M FROM RUNWAY PHYSICAL ENDS    |
|        | WIND CONE / WDI      | AS SHOWN                          |
|        | CONNECTION FROM CCR3 | AS SHOWN                          |
|        | CONNECTION FROM CCR2 | AS SHOWN                          |

| SYMBOL | DESCRIPTION  | SIZE                          |
|--------|--|-------------------------------|
|        | AGL PRIMARY CABLE - A (CIRCUIT WRE 1 CONNECTED TO CCR 1) | 6MM <sup>2</sup> ( 1 CORE)    |
|        | AGL SECONDARY CABLE - A                                  | 2.5 MM <sup>2</sup> ( 2 CORE) |
|        | SERVICE DUCT   | -                             |

KEY PLAN

M. PRABHU  
CONSULTANT SIGNATURE

19-08-2019  
DATE

APPROVAL OF REGIONAL AIRPORT  
MALDIVES

DATE

REFERENCE CONSTRUCTION DRAWING NUMBER

REV

T1713-TOS-33000-CV-DW-0011

A4

AS-BUILT

Description

Date

AS-BUILT

19/08/2019

DRAWING STATUS

APPROVED

REJECTED

N. MAAFARU AIRPORT

AIRFIELD LIGHTING &  
LANDING AIDS

Drawing Title:

AGL CABLE - A (PRIMARY & SECONDARY)  
LAYOUT (GRID 25~48)

Employer:

REGIONAL AIRPORTS  
MINISTRY OF TOURISM

Funder:

صندوق أبوظبي للتنمية  
ABU DHABI FUND FOR DEVELOPMENT

Contractor:

Consultant:

Supervision & Management Consultant:

Issue: AB

Date: AUG-2019


Pages: 11 of 38

Scale: N.T.S

Paper: A3

DWG #: T1713-TOS-33000-CV-DW-0011




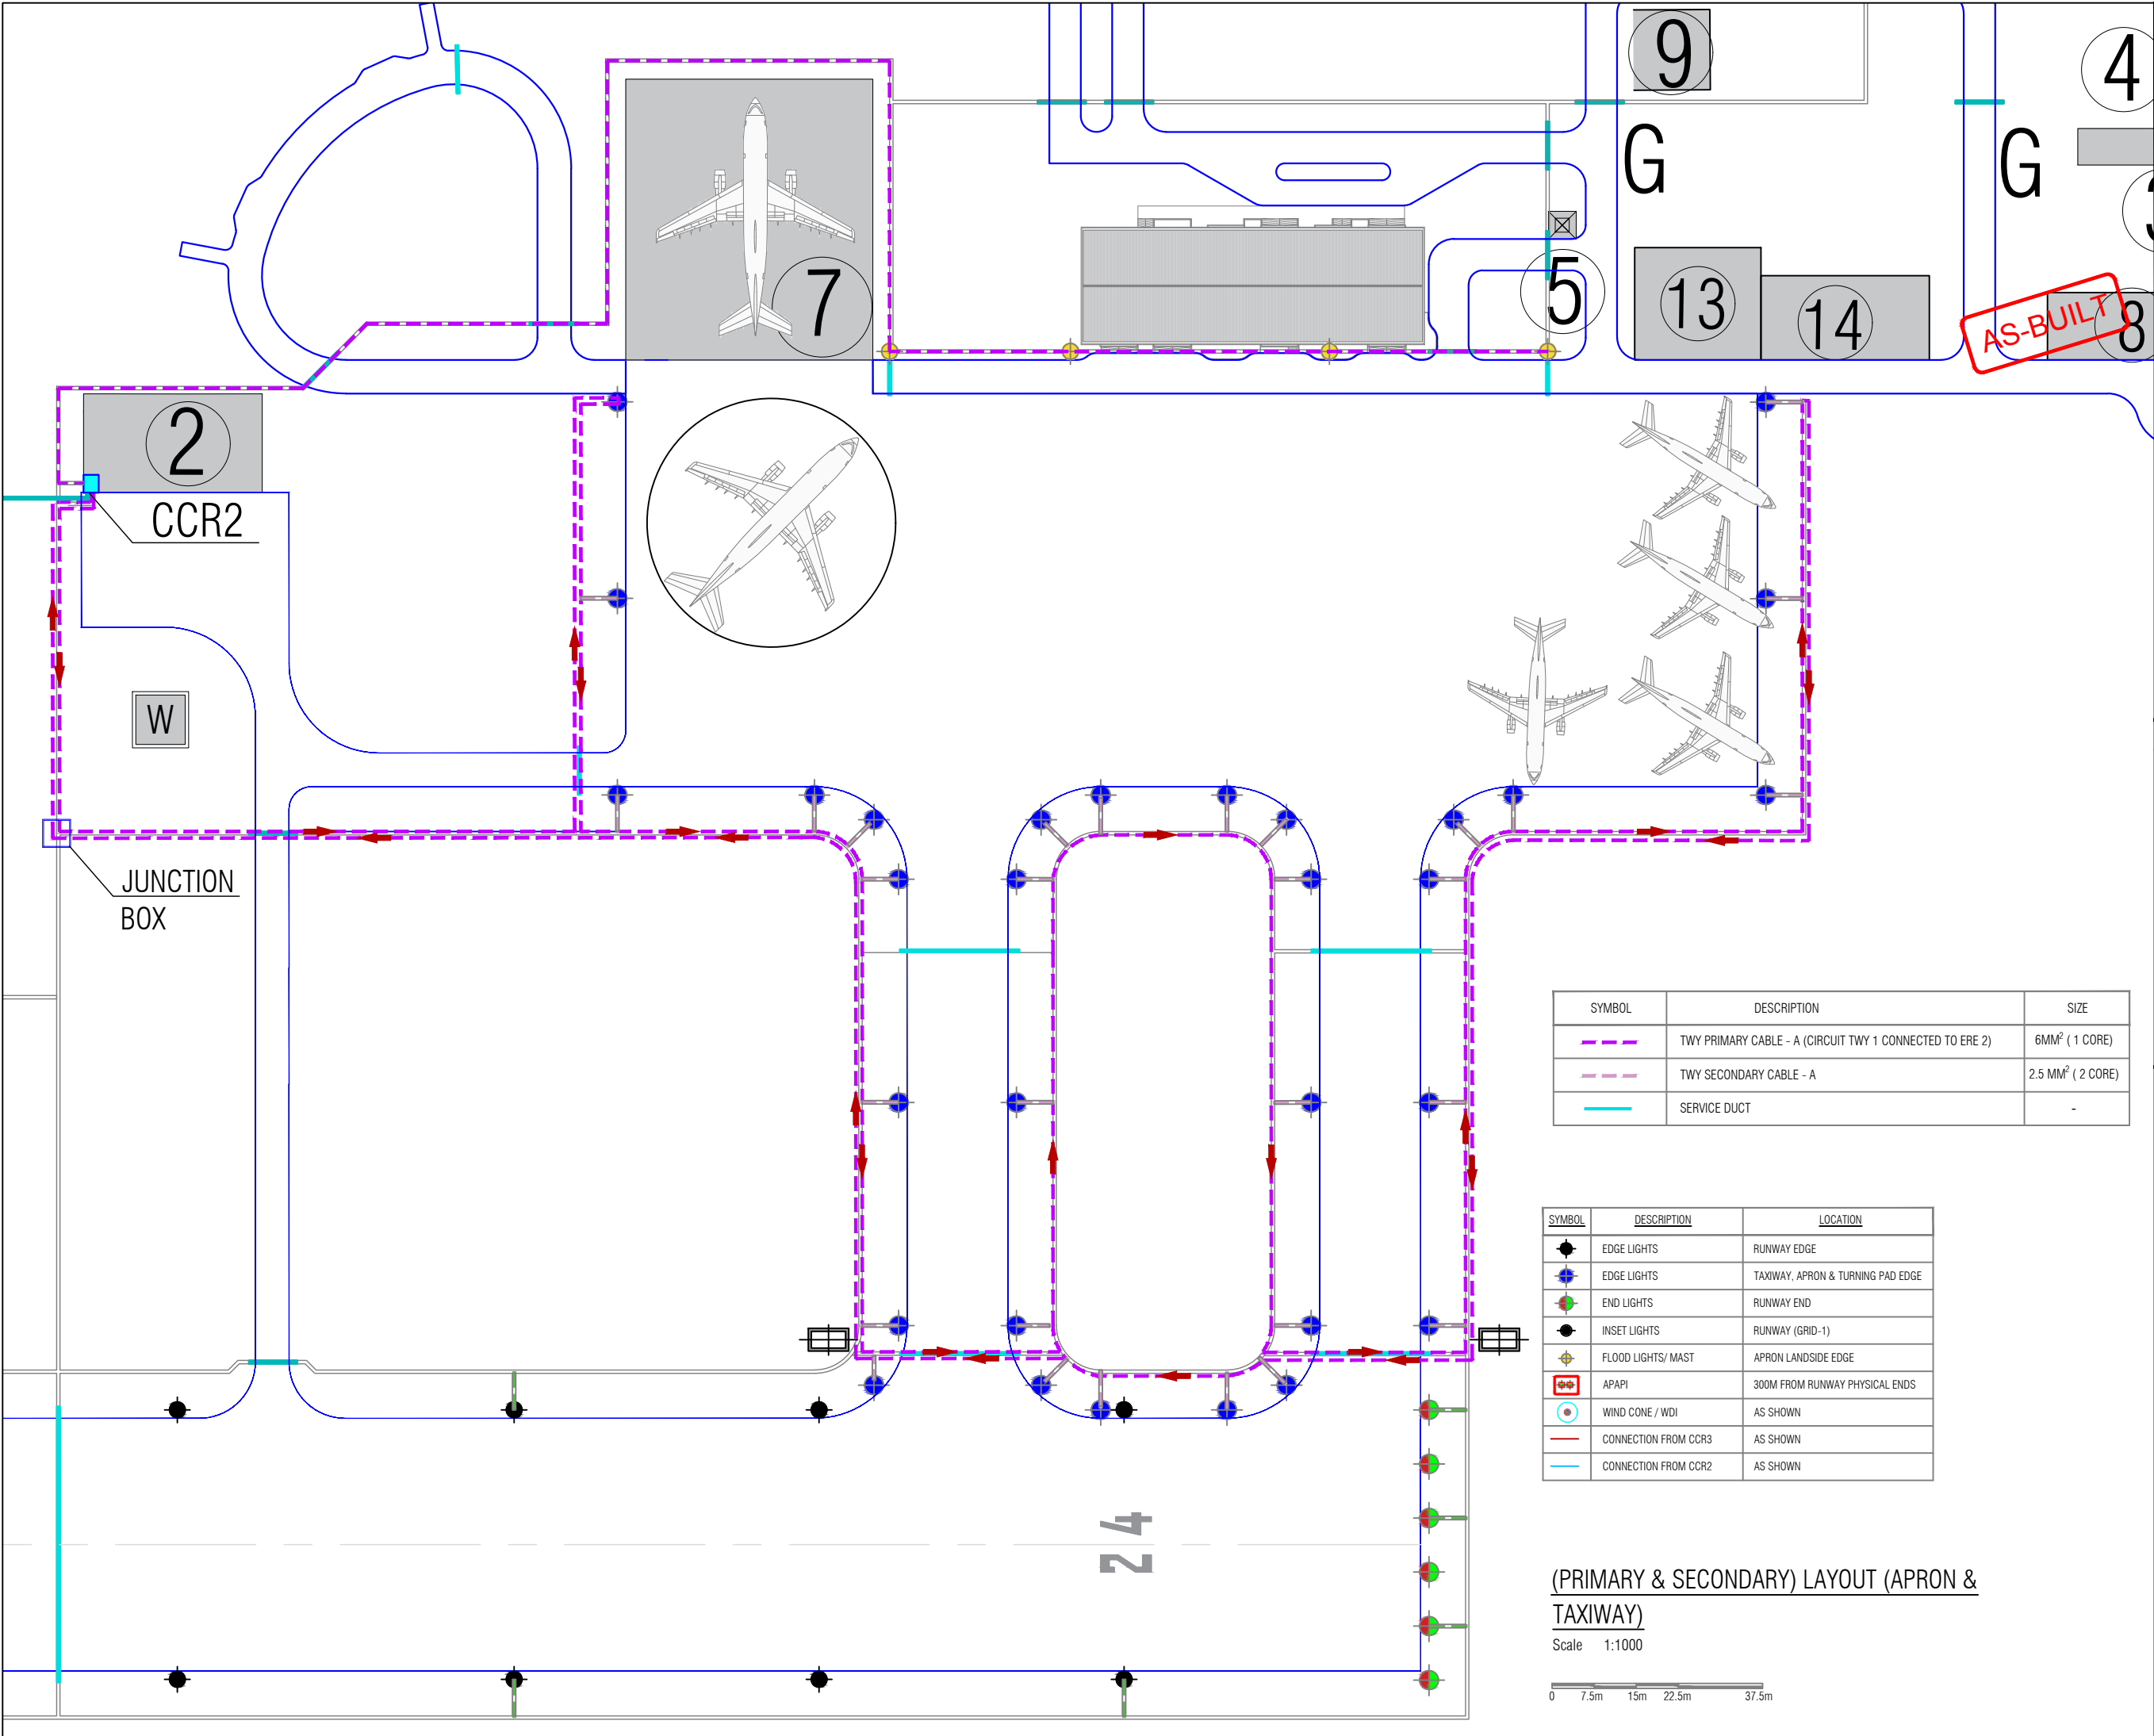

| SYMBOL | DESCRIPTION  | SIZE              |
|--------|--|-------------------|
|        | TWY PRIMARY CABLE - A (CIRCUIT TWY 1 CONNECTED TO ERE 2) | 6MM² ( 1 CORE)    |
|        | TWY SECONDARY CABLE - A                                  | 2.5 MM² ( 2 CORE) |
|        | SERVICE DUCT   | -                 |

| SYMBOL | DESCRIPTION          | LOCATION                          |
|--------|----------------------|-----------------------------------|
|        | EDGE LIGHTS          | RUNWAY EDGE                       |
|        | EDGE LIGHTS          | TAXIWAY, APRON & TURNING PAD EDGE |
|        | END LIGHTS           | RUNWAY END                        |
|        | INSET LIGHTS         | RUNWAY (GRID-1)                   |
|        | FLOOD LIGHTS/ MAST   | APRON LANDSIDE EDGE               |
|        | APAPI                | 300M FROM RUNWAY PHYSICAL ENDS    |
|        | WIND CONE / WDI      | AS SHOWN                          |
|        | CONNECTION FROM CCR3 | AS SHOWN                          |
|        | CONNECTION FROM CCR2 | AS SHOWN                          |

 (PRIMARY & SECONDARY) LAYOUT (APRON & TAXIWAY)  
Scale 1:1000



KEY PLAN

M. PRABHU

CONSULTANT SIGNATURE

19-08-2019

DATE

APPROVAL OF REGIONAL AIRPORT

MALDIVES

DATE

REFERENCE CONSTRUCTION DRAWING NUMBER

T1713-TOS-33000-CV-DW-0012

REV

A4

AS-BUILT

Description

AS-BUILT

Date

19/08/2019

DRAWING STATUS

APPROVED

REJECTED

N. MAAFARU AIRPORT

AIRFIELD LIGHTING & LANDING AIDS

Drawing Title:

AGL CABLE - A (PRIMARY & SECONDARY) LAYOUT (APRON & TAXIWAY)

Employer:

REGIONAL AIRPORTS

MINISTRY OF TOURISM

Funder:

صندوق أبوظبي للتنمية

ABU DHABI FUND FOR DEVELOPMENT

Contractor:

TUFF

Consultant:

HOCHTIEF

INDIA

Supervision & Management Consultant:

ARMSTRONG

Issue: AB

Date: AUG-2019


Pages: 12 of 38

Scale: N.T.S

Paper: A3

DWG #: T1713-TOS-33000-CV-DW-0012



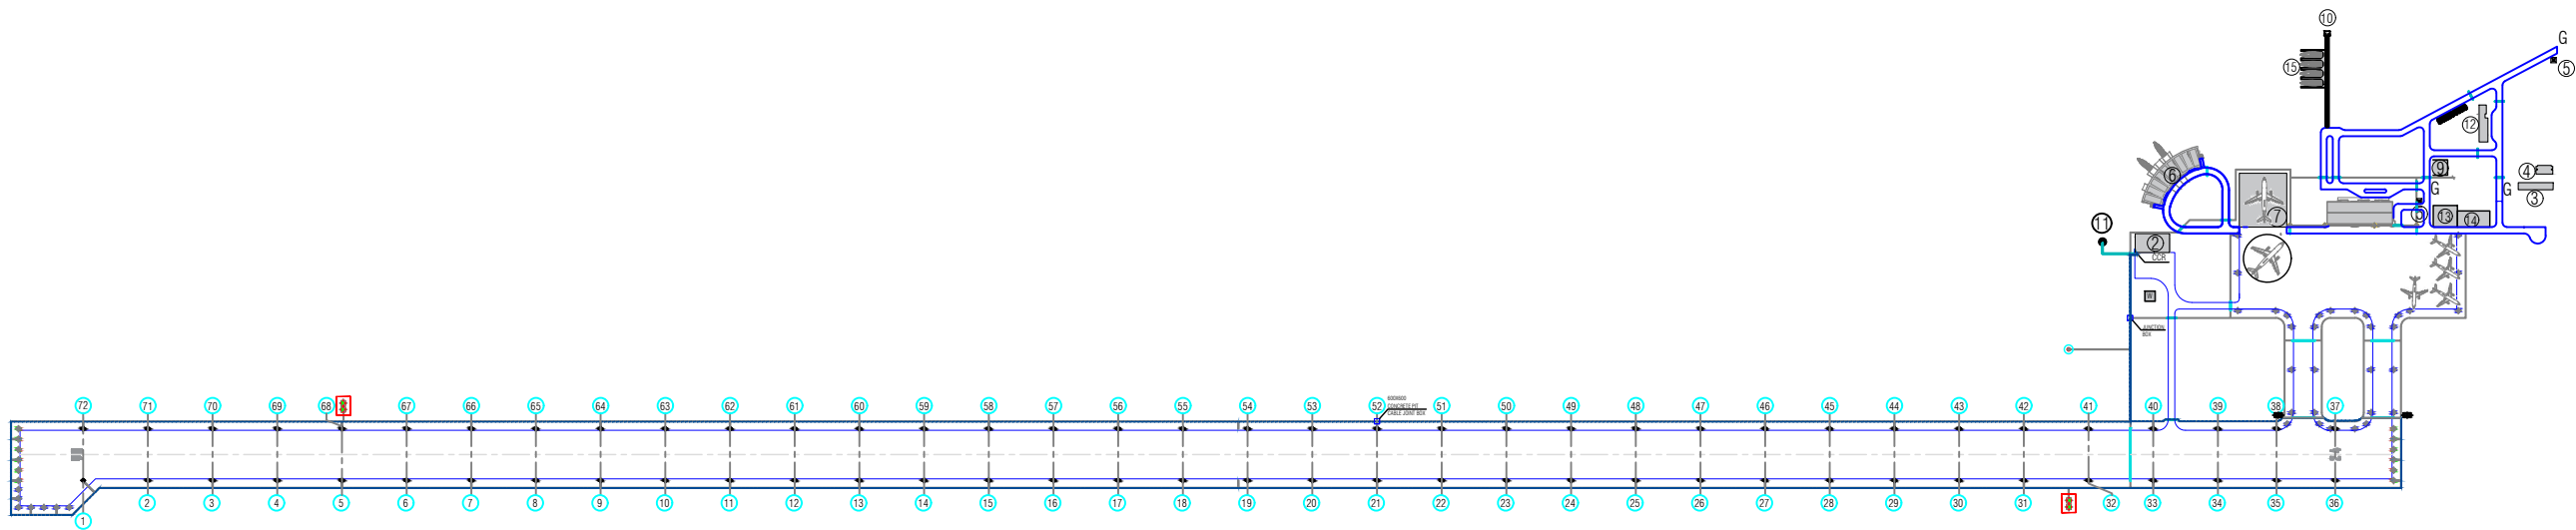


AGL PRIMARY CABLE - B LAYOUT

Scale 1:7000



| SYMBOL | DESCRIPTION  | SIZE                          |
|--------|--|-------------------------------|
|        | AGL PRIMARY CABLE - B (CIRCUIT ERE 2 CONNECTED TO CCR 2) | 6 MM <sup>2</sup> ( 1 CORE)   |
|        | AGL SECONDARY CABLE - B                                  | 2.5 MM <sup>2</sup> ( 2 CORE) |
|        | SERVICE DUCT   | -                             |

KEY PLAN

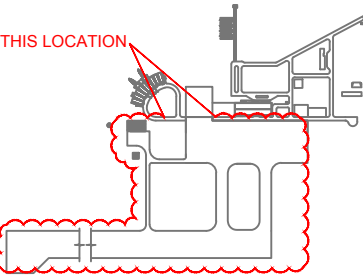

M. PRABHU  
CONSULTANT SIGNATURE

19-08-2019  
DATE

APPROVAL OF REGIONAL AIRPORT  
MALDIVES

DATE

| REFERENCE CONSTRUCTION DRAWING NUMBER | REV |
|---------------------------------------|-----|
| T1713-TOS-33000-CV-DW-0013            | A4  |

| AS-BUILT    |            |
|-------------|------------|
| Description | Date       |
| AS-BUILT    | 19/08/2019 |

DRAWING STATUS ☒ APPROVED ☐ REJECTED

N. MAAFARU AIRPORT  
AIRFIELD LIGHTING &  
LANDING AIDS

Drawing Title:  
AGL PRIMARY CABLE - B LAYOUT

Employer:  
REGIONAL AIRPORTS  
MINISTRY OF TOURISM




Funder:  
  
صندوق أبوظبي للتنمية  
ABU DHABI FUND FOR DEVELOPMENT

Contractor:  
  
TUFF

Consultant:  
  
HOCHTIEF  
INDIA

Supervision & Management Consultant:  
  
ARMSTRONG

|                                   |                |                 |
|-----------------------------------|----------------|-----------------|
| Issue: AB                         | Date: AUG-2019 | Pages: 13 of 38 |
| Scale: N.T.S                      | Paper: A3      |                 |
| DWG #: T1713-TOS-33000-CV-DW-0013 |                |                 |

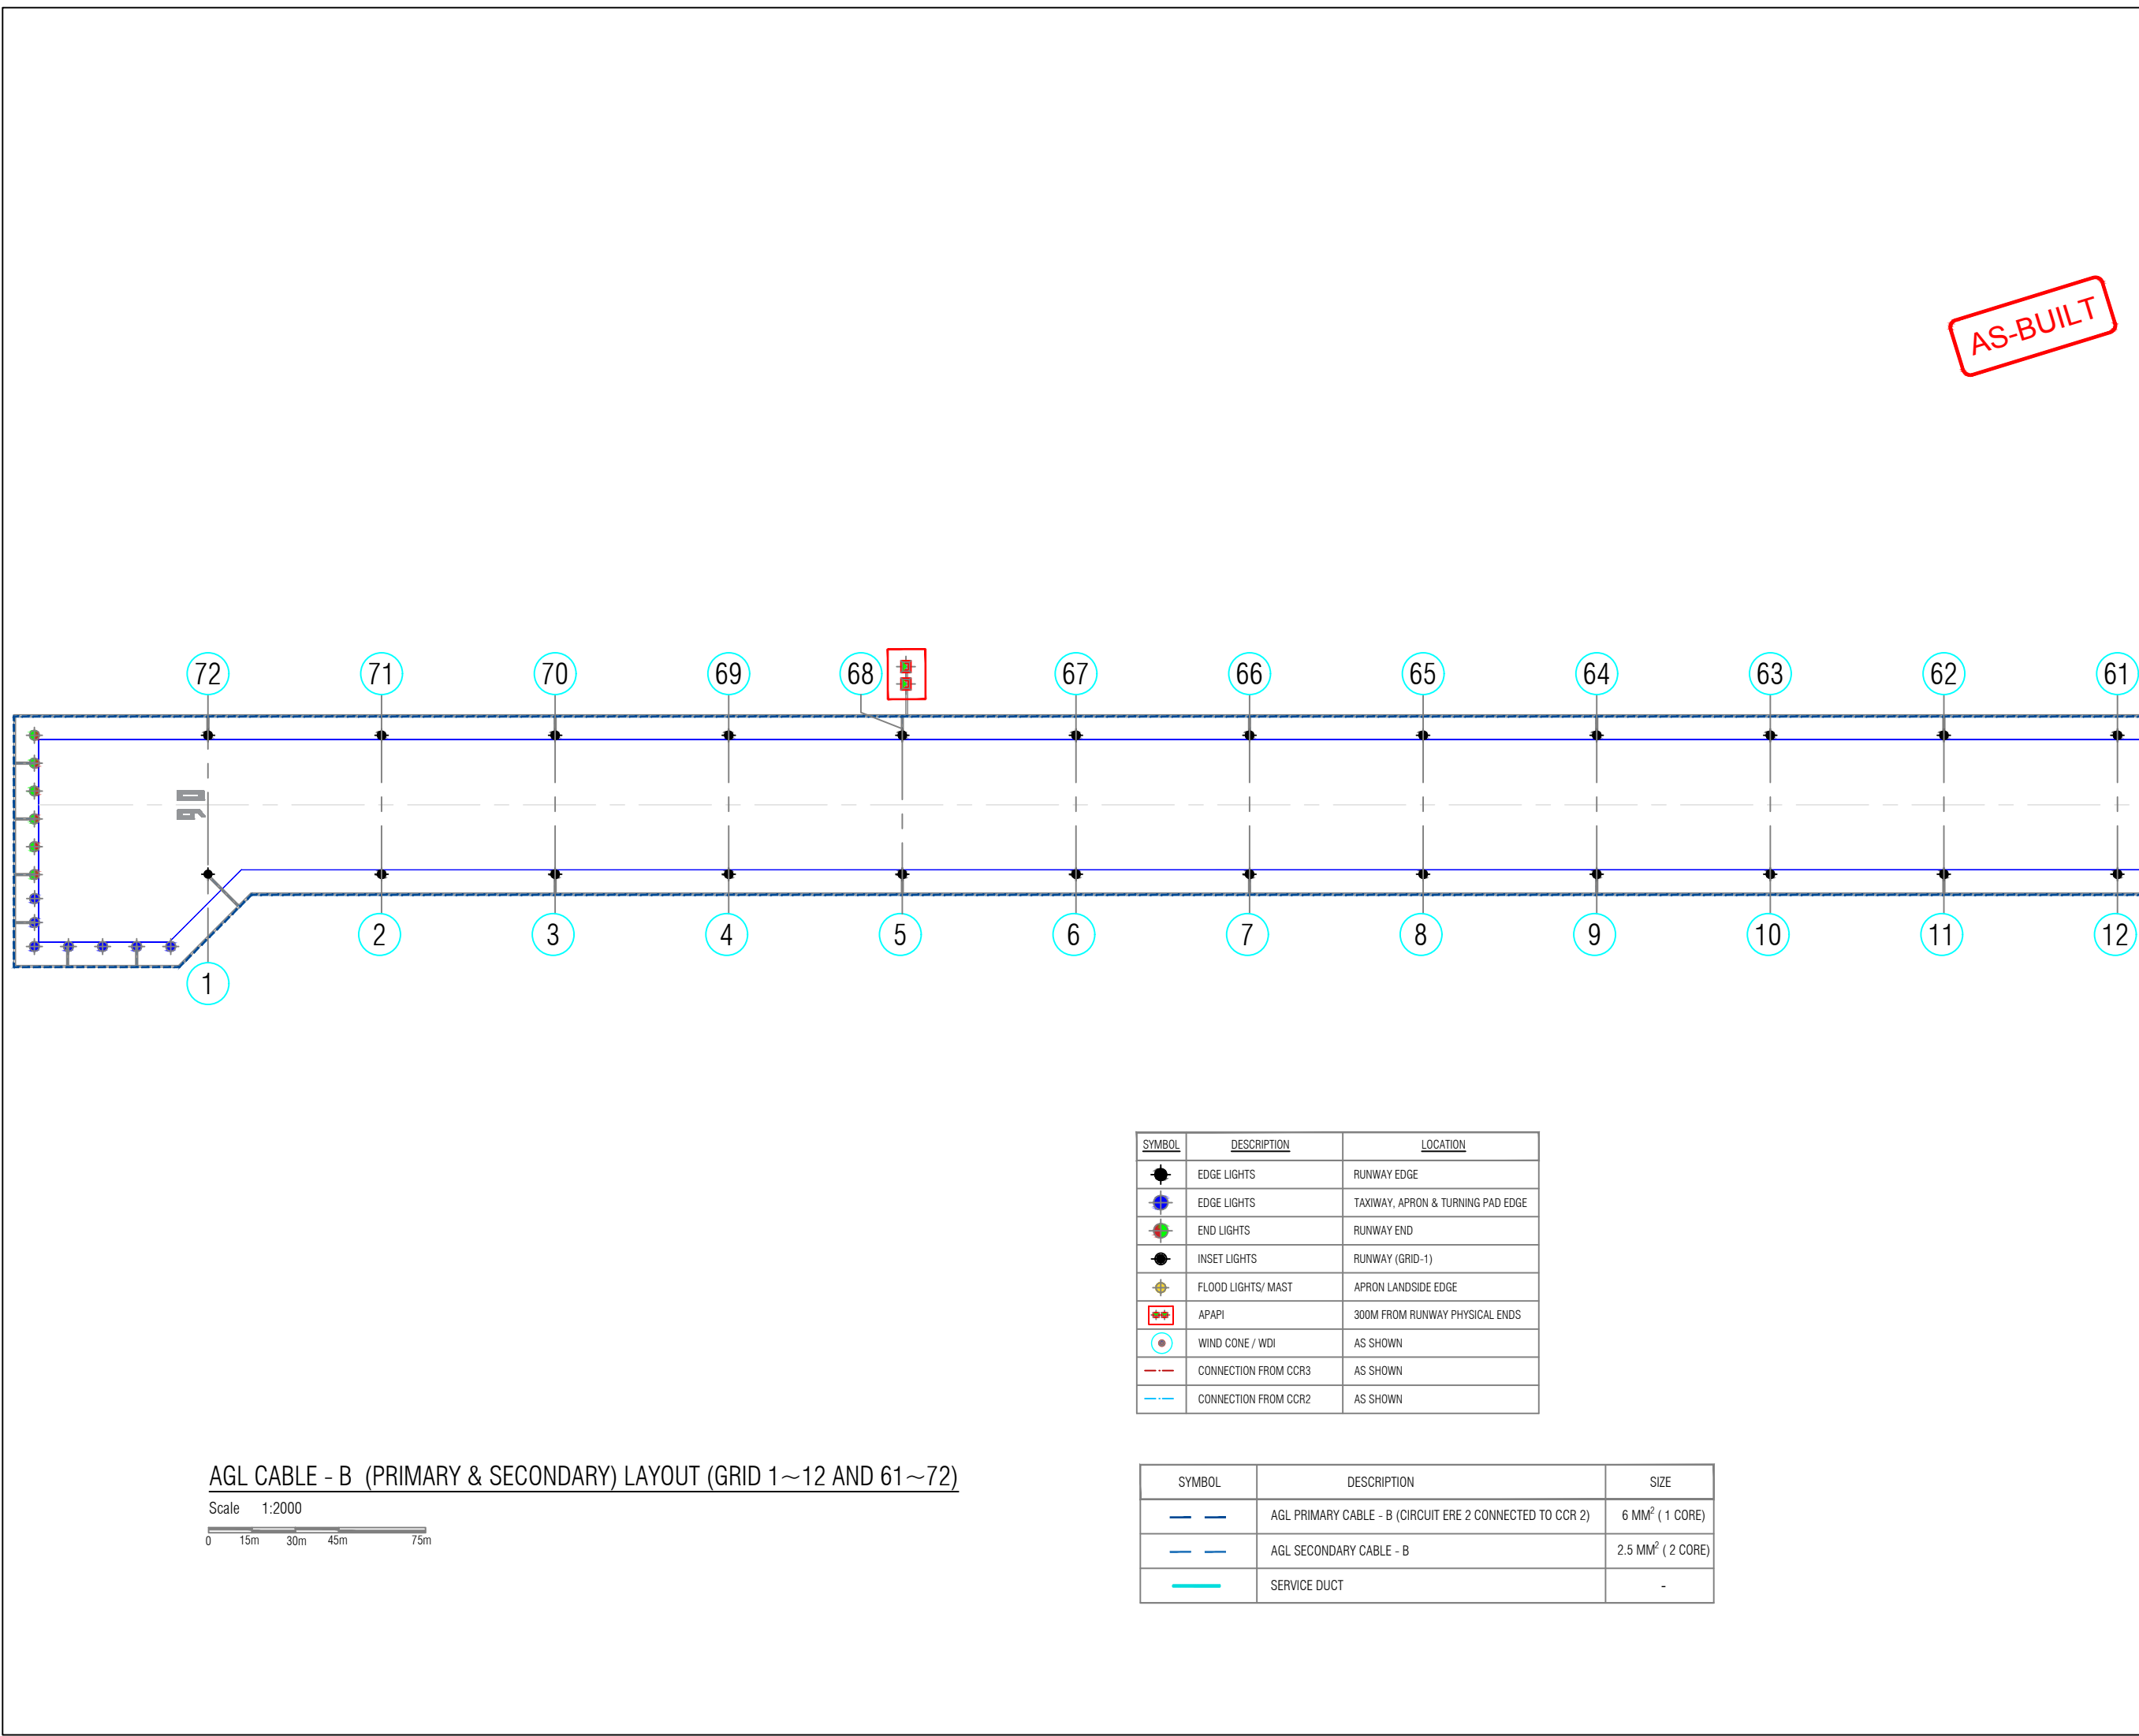

| SYMBOL | DESCRIPTION          | LOCATION                          |
|--------|----------------------|-----------------------------------|
|        | EDGE LIGHTS          | RUNWAY EDGE                       |
|        | EDGE LIGHTS          | TAXIWAY, APRON & TURNING PAD EDGE |
|        | END LIGHTS           | RUNWAY END                        |
|        | INSET LIGHTS         | RUNWAY (GRID-1)                   |
|        | FLOOD LIGHTS/ MAST   | APRON LANDSIDE EDGE               |
|        | APAPI                | 300M FROM RUNWAY PHYSICAL ENDS    |
|        | WIND CONE / WDI      | AS SHOWN                          |
|        | CONNECTION FROM CCR3 | AS SHOWN                          |
|        | CONNECTION FROM CCR2 | AS SHOWN                          |

| SYMBOL | DESCRIPTION  | SIZE                          |
|--------|--|-------------------------------|
|        | AGL PRIMARY CABLE - B (CIRCUIT ERE 2 CONNECTED TO CCR 2) | 6 MM <sup>2</sup> ( 1 CORE)   |
|        | AGL SECONDARY CABLE - B                                  | 2.5 MM <sup>2</sup> ( 2 CORE) |
|        | SERVICE DUCT   | -                             |

KEY PLAN

AS-BUILT

M. PRABHU  
CONSULTANT SIGNATURE

19-08-2019  
DATE

APPROVAL OF REGIONAL AIRPORT  
MALDIVES

DATE

REFERENCE CONSTRUCTION DRAWING NUMBER

REV

T1713-TOS-33000-CV-DW-0014

A4

AS-BUILT

Description

Date

AS-BUILT

19/08/2019

DRAWING STATUS

APPROVED

REJECTED

N. MAAFARU AIRPORT

AIRFIELD LIGHTING & LANDING AIDS

Drawing Title:

AGL CABLE - B (PRIMARY & SECONDARY) LAYOUT (GRID 1~12 AND 61~72)

Employer:

REGIONAL AIRPORTS  
MINISTRY OF TOURISM

Funder:

صندوق أبوظبي للتنمية  
ABU DHABI FUND FOR DEVELOPMENT

Contractor:

Consultant:

INDIA

Supervision & Management Consultant:

Issue: AB


Date: AUG-2019

Pages: 14 of 38

Scale: N.T.S

Paper: A3

DWG #: T1713-TOS-33000-CV-DW-0014

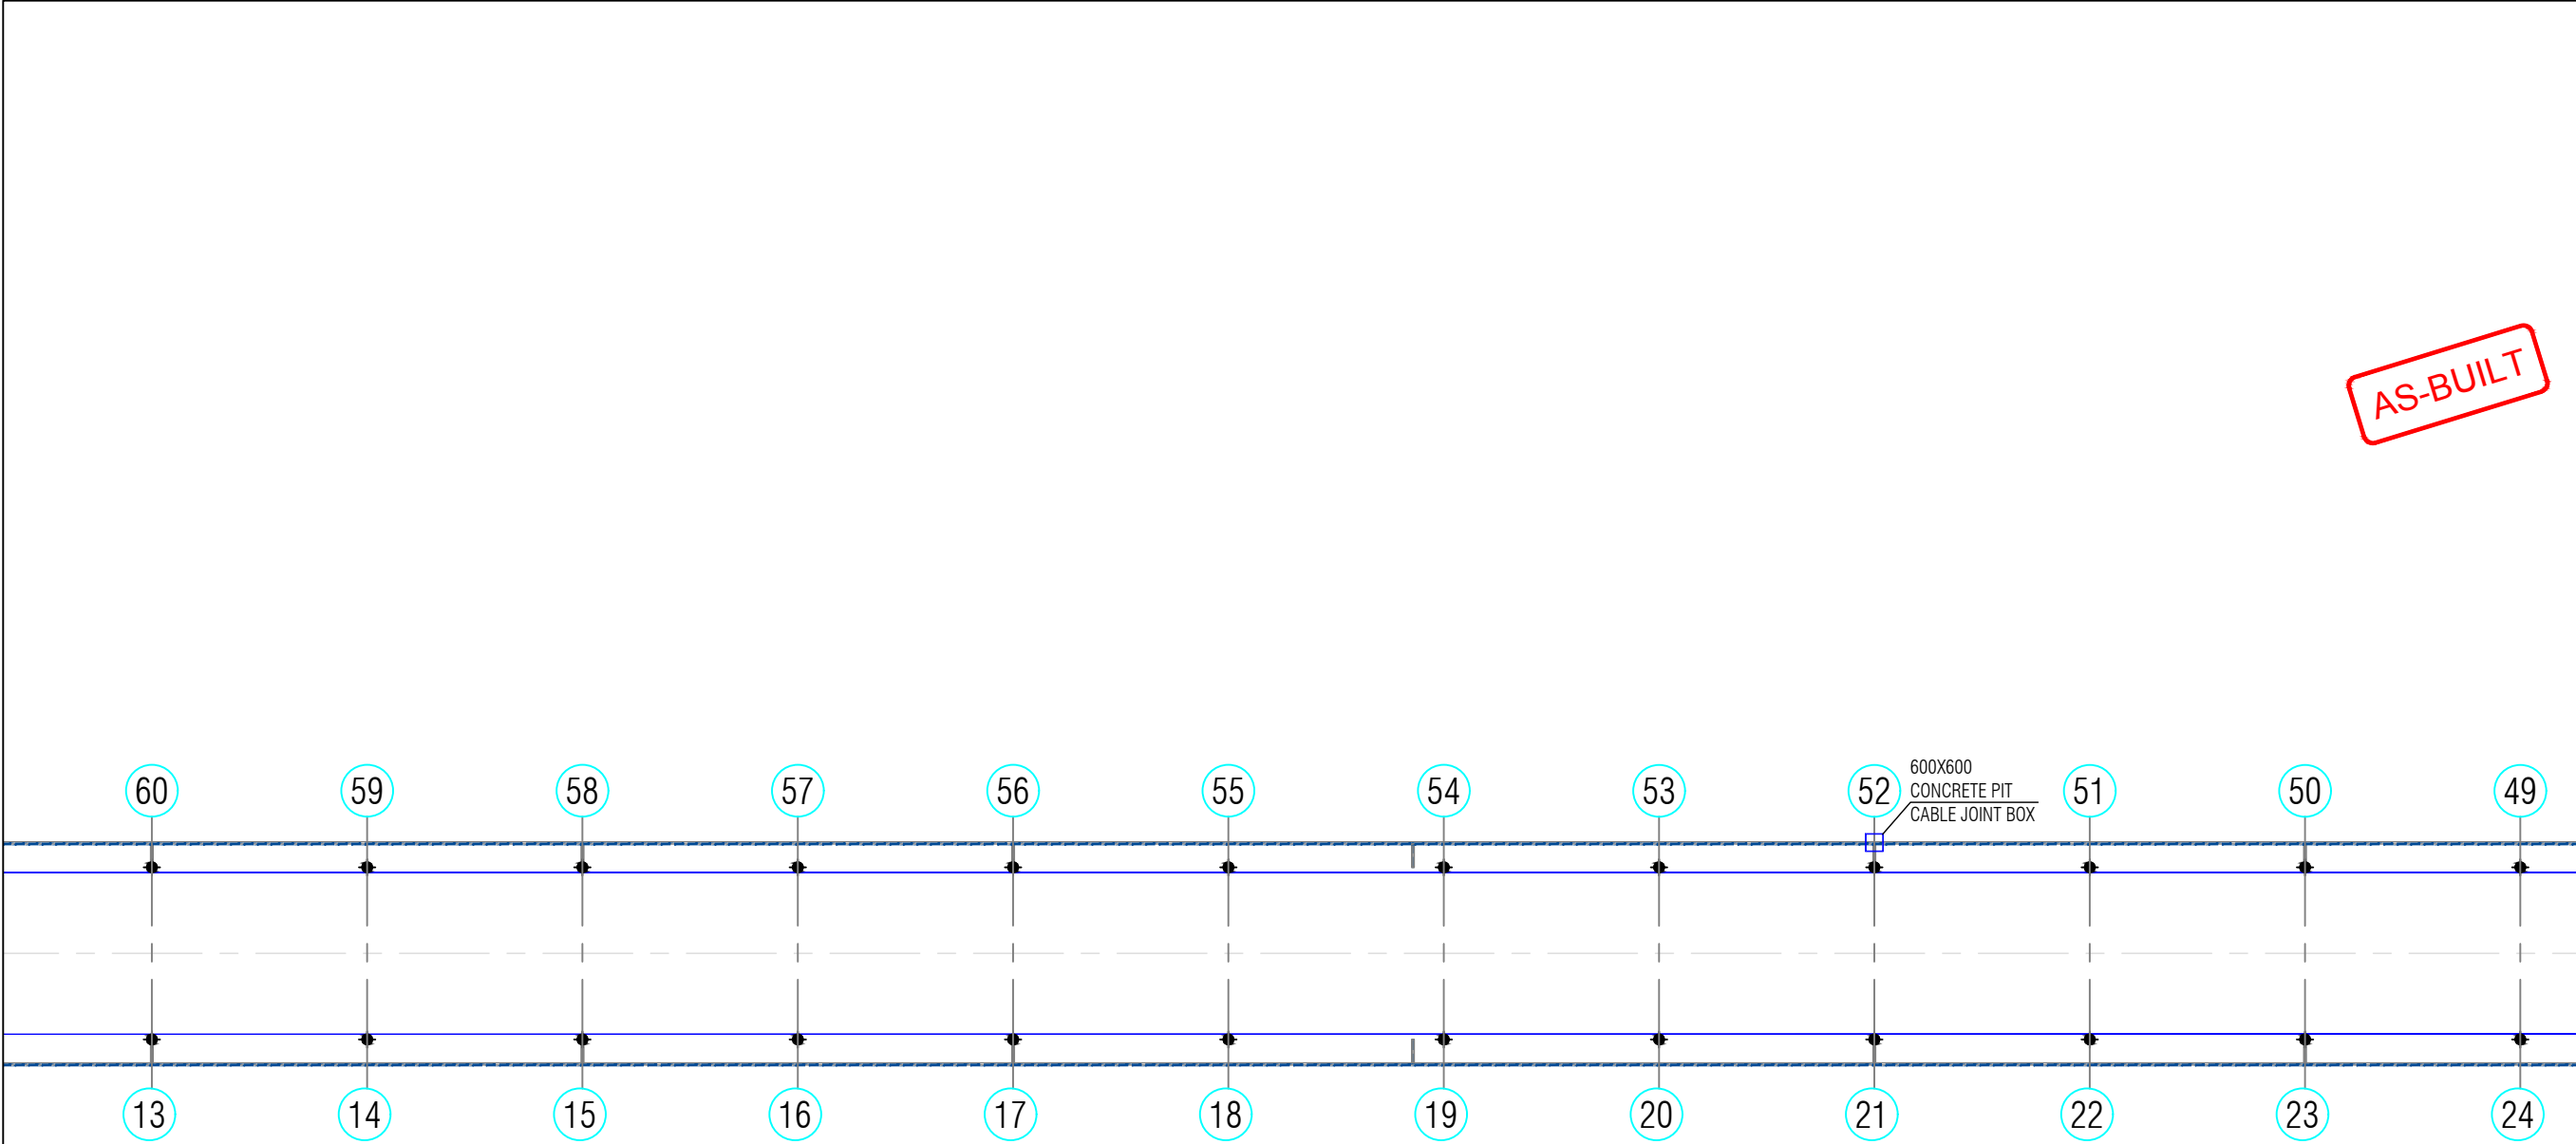

AGL CABLE - B (PRIMARY & SECONDARY) LAYOUT (GRID 13~24 AND 49~60)



| SYMBOL | DESCRIPTION          | LOCATION                          |
|--------|----------------------|-----------------------------------|
|        | EDGE LIGHTS          | RUNWAY EDGE                       |
|        | EDGE LIGHTS          | TAXIWAY, APRON & TURNING PAD EDGE |
|        | END LIGHTS           | RUNWAY END                        |
|        | INSET LIGHTS         | RUNWAY (GRID-1)                   |
|        | FLOOD LIGHTS/ MAST   | APRON LANDSIDE EDGE               |
|        | APAPI                | 300M FROM RUNWAY PHYSICAL ENDS    |
|        | WIND CONE / WDI      | AS SHOWN                          |
|        | CONNECTION FROM CCR3 | AS SHOWN                          |
|        | CONNECTION FROM CCR2 | AS SHOWN                          |

| SYMBOL | DESCRIPTION  | SIZE                          |
|--------|--|-------------------------------|
|        | AGL PRIMARY CABLE - B (CIRCUIT ERE 2 CONNECTED TO CCR 2) | 6 MM <sup>2</sup> ( 1 CORE)   |
|        | AGL SECONDARY CABLE - B                                  | 2.5 MM <sup>2</sup> ( 2 CORE) |
|        | SERVICE DUCT   | -                             |

KEY PLAN

M. PRABHU  
CONSULTANT SIGNATURE

19-08-2019  
DATE

APPROVAL OF REGIONAL AIRPORT  
MALDIVES

DATE

REFERENCE CONSTRUCTION DRAWING NUMBER

REV

T1713-TOS-33000-CV-DW-0015

A4

AS-BUILT

Description

Date

AS-BUILT

19/08/2019

DRAWING STATUS

APPROVED

REJECTED

N. MAAFARU AIRPORT

AIRFIELD LIGHTING &  
LANDING AIDS

Drawing Title:

AGL CABLE - B (PRIMARY & SECONDARY)  
LAYOUT (GRID 13~24 AND 49~60)

Employer:

REGIONAL AIRPORTS  
MINISTRY OF TOURISM

Funder:

صندوق أبوظبي للتنمية  
ABU DHABI FUND FOR DEVELOPMENT

Contractor:

Consultant:

Supervision & Management Consultant:

Issue: AB


Date: AUG-2019

Pages: 15 of 38


Scale: N.T.S

Paper: A3

DWG #: T1713-TOS-33000-CV-DW-0015

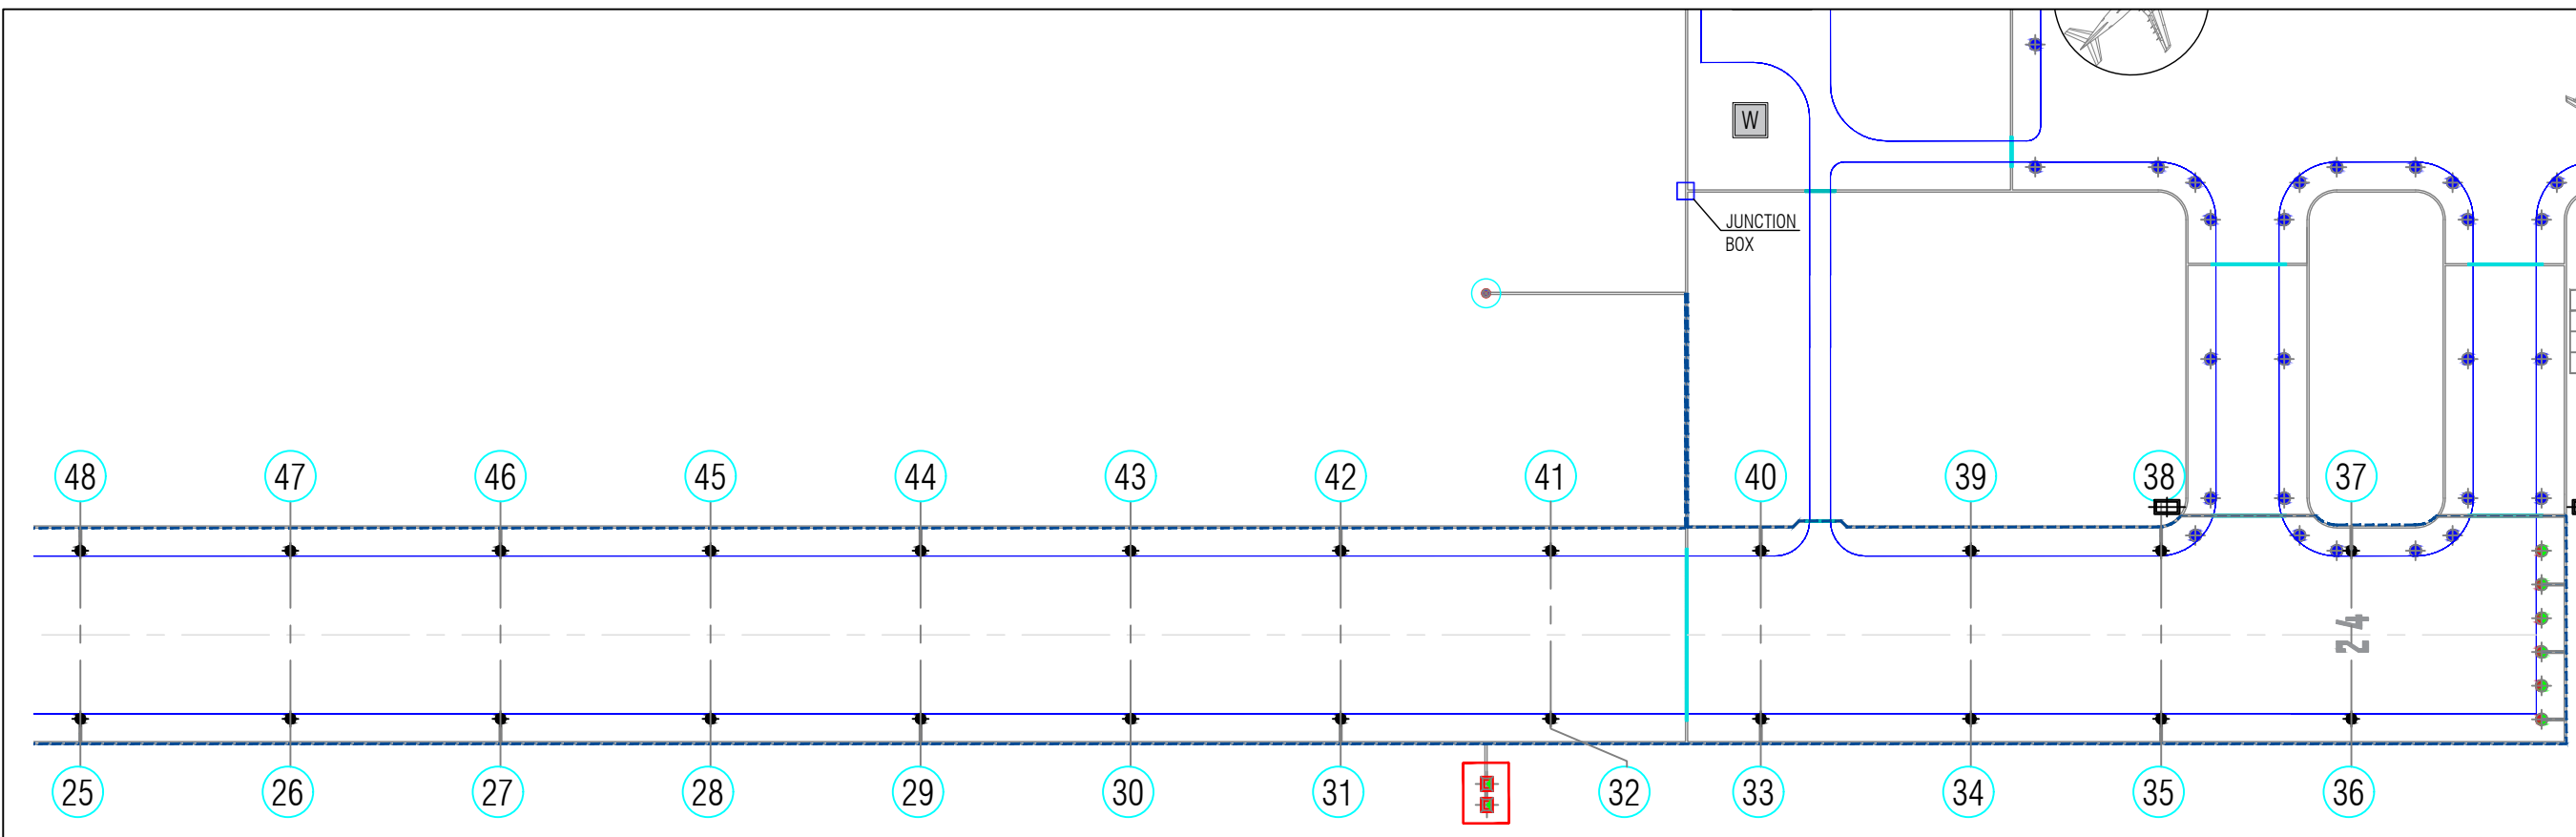

AGL CABLE - B (PRIMARY & SECONDARY) LAYOUT (GRID 25~48)

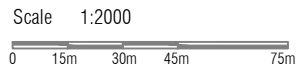

| SYMBOL | DESCRIPTION          | LOCATION                          |
|--------|----------------------|-----------------------------------|
|        | EDGE LIGHTS          | RUNWAY EDGE                       |
|        | EDGE LIGHTS          | TAXIWAY, APRON & TURNING PAD EDGE |
|        | END LIGHTS           | RUNWAY END                        |
|        | INSET LIGHTS         | RUNWAY (GRID-1)                   |
|        | FLOOD LIGHTS/ MAST   | APRON LANDSIDE EDGE               |
|        | APAPI                | 300M FROM RUNWAY PHYSICAL ENDS    |
|        | WIND CONE / WDI      | AS SHOWN                          |
|        | CONNECTION FROM CCR3 | AS SHOWN                          |
|        | CONNECTION FROM CCR2 | AS SHOWN                          |

| SYMBOL | DESCRIPTION  | SIZE                          |
|--------|--|-------------------------------|
|        | AGL PRIMARY CABLE - B (CIRCUIT ERE 2 CONNECTED TO CCR 2) | 6 MM <sup>2</sup> ( 1 CORE)   |
|        | AGL SECONDARY CABLE - B                                  | 2.5 MM <sup>2</sup> ( 2 CORE) |
|        | SERVICE DUCT   | -                             |

KEY PLAN

M. PRABHU

CONSULTANT SIGNATURE

19-08-2019

DATE

APPROVAL OF REGIONAL AIRPORT

MALDIVES

DATE

REFERENCE CONSTRUCTION DRAWING NUMBER

T1713-TOS-33000-CV-DW-0016

REV

A4

AS-BUILT

Description

AS-BUILT

Date

19/08/2019

DRAWING STATUS

APPROVED

REJECTED

N. MAAFARU AIRPORT

AIRFIELD LIGHTING & LANDING AIDS

Drawing Title:

AGL CABLE - B (PRIMARY & SECONDARY) LAYOUT (GRID 25~48)

Employer:

REGIONAL AIRPORTS

MINISTRY OF TOURISM

Funder:

صندوق أبوظبي للتنمية

ABU DHABI FUND FOR DEVELOPMENT

Contractor:

TUFF

Consultant:

HOCHTIEF

INDIA

Supervision & Management Consultant:

ARMSTRONG

Issue: AB


Date: AUG-2019

Pages: 16 of 38

Scale: N.T.S

Paper: A3

DWG #: T1713-TOS-33000-CV-DW-0016

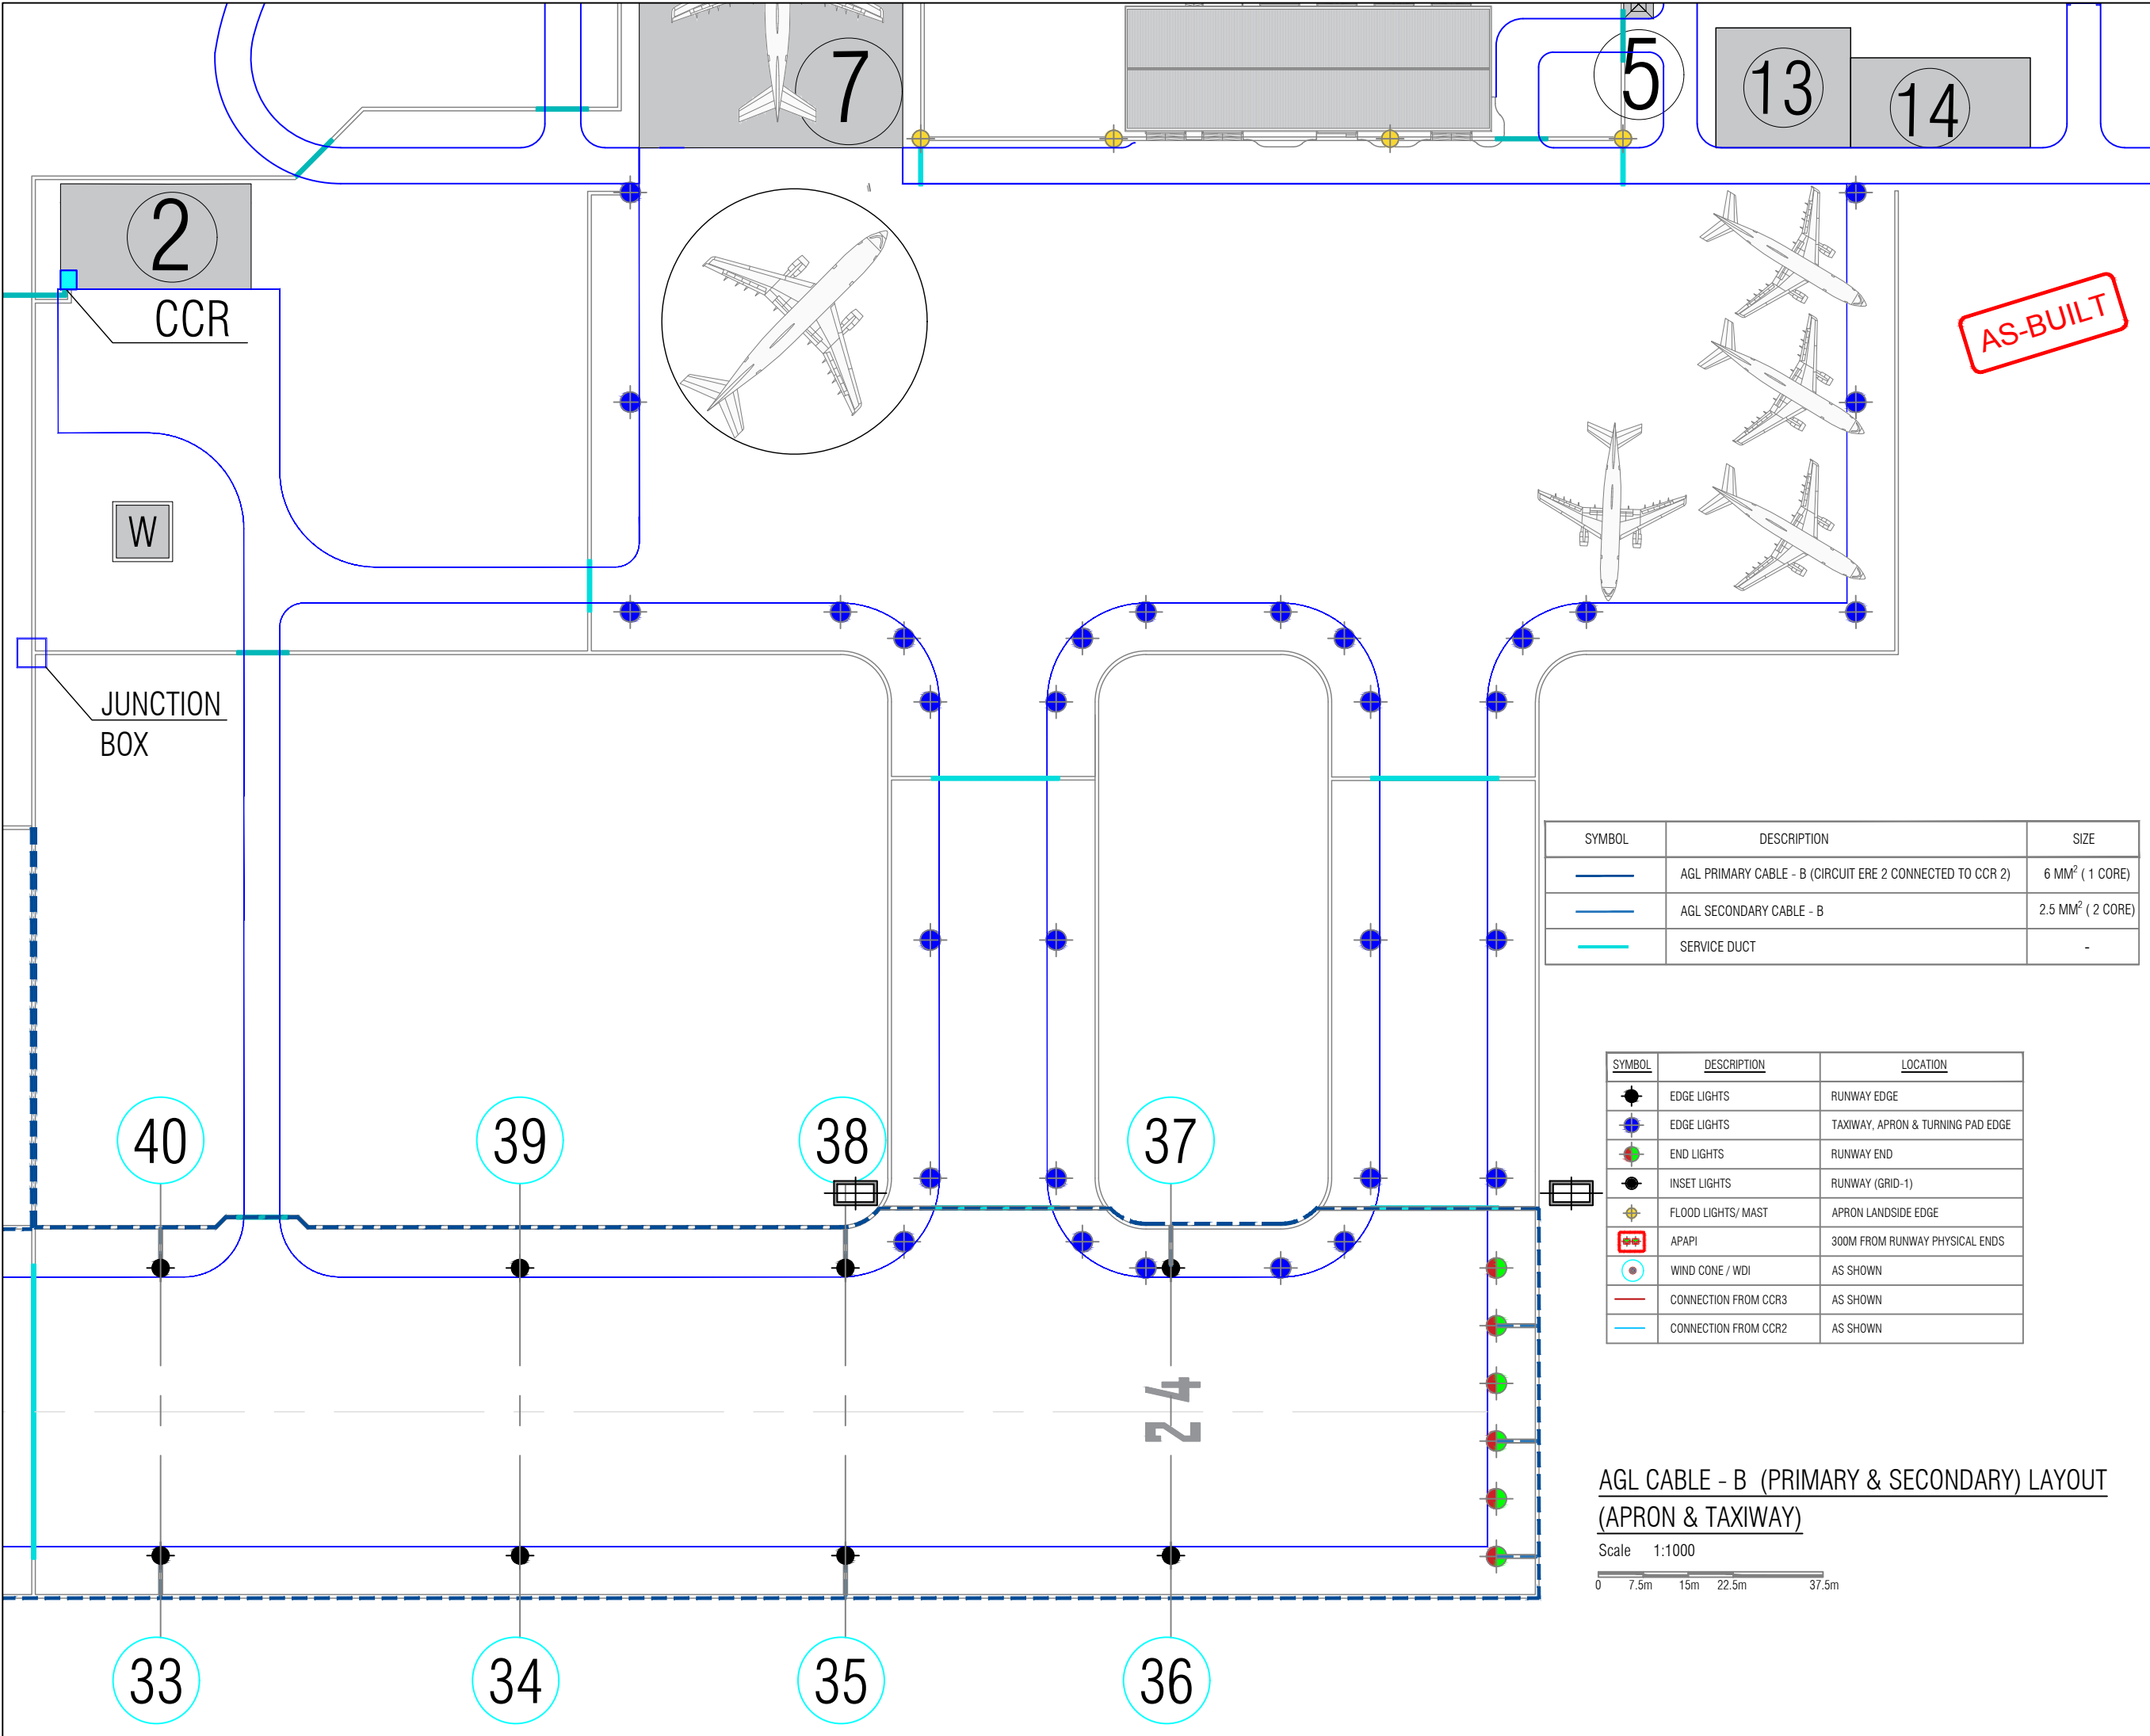

| SYMBOL | DESCRIPTION  | SIZE                          |
|--------|--|-------------------------------|
|        | AGL PRIMARY CABLE - B (CIRCUIT ERE 2 CONNECTED TO CCR 2) | 6 MM <sup>2</sup> ( 1 CORE)   |
|        | AGL SECONDARY CABLE - B                                  | 2.5 MM <sup>2</sup> ( 2 CORE) |
|        | SERVICE DUCT   | -                             |

| SYMBOL | DESCRIPTION          | LOCATION                          |
|--------|----------------------|-----------------------------------|
|        | EDGE LIGHTS          | RUNWAY EDGE                       |
|        | EDGE LIGHTS          | TAXIWAY, APRON & TURNING PAD EDGE |
|        | END LIGHTS           | RUNWAY END                        |
|        | INSET LIGHTS         | RUNWAY (GRID-1)                   |
|        | FLOOD LIGHTS/ MAST   | APRON LANDSIDE EDGE               |
|        | APAPI                | 300M FROM RUNWAY PHYSICAL ENDS    |
|        | WIND CONE / WDI      | AS SHOWN                          |
|        | CONNECTION FROM CCR3 | AS SHOWN                          |
|        | CONNECTION FROM CCR2 | AS SHOWN                          |

AGL CABLE - B (PRIMARY & SECONDARY) LAYOUT  
(APRON & TAXIWAY)

Scale 1:1000  
0 7.5m 15m 22.5m 37.5m

KEY PLAN

M. PRABHU  
CONSULTANT SIGNATURE

19-08-2019  
DATE

APPROVAL OF REGIONAL AIRPORT  
MALDIVES

DATE

REFERENCE CONSTRUCTION DRAWING NUMBER

REV

T1713-TOS-33000-CV-DW-0017

A4

AS-BUILT

Description

Date

AS-BUILT

19/08/2019

DRAWING STATUS

APPROVED

REJECTED

N. MAAFARU AIRPORT

AIRFIELD LIGHTING &  
LANDING AIDS

Drawing Title:

AGL CABLE - B (PRIMARY & SECONDARY)  
LAYOUT (APRON & TAXIWAY)

Employer:

REGIONAL AIRPORTS  
MINISTRY OF TOURISM

Funder:

صندوق أبوظبي للتنمية  
ABU DHABI FUND FOR DEVELOPMENT

Contractor:

TUFF

Consultant:

HOCHTIEF  
INDIA

Supervision & Management Consultant:

ARMSTRONG

Issue: AB


Date: AUG-2019

Pages: 17 of 38

Scale: N.T.S


Paper: A3

DWG #: T1713-TOS-33000-CV-DW-0017

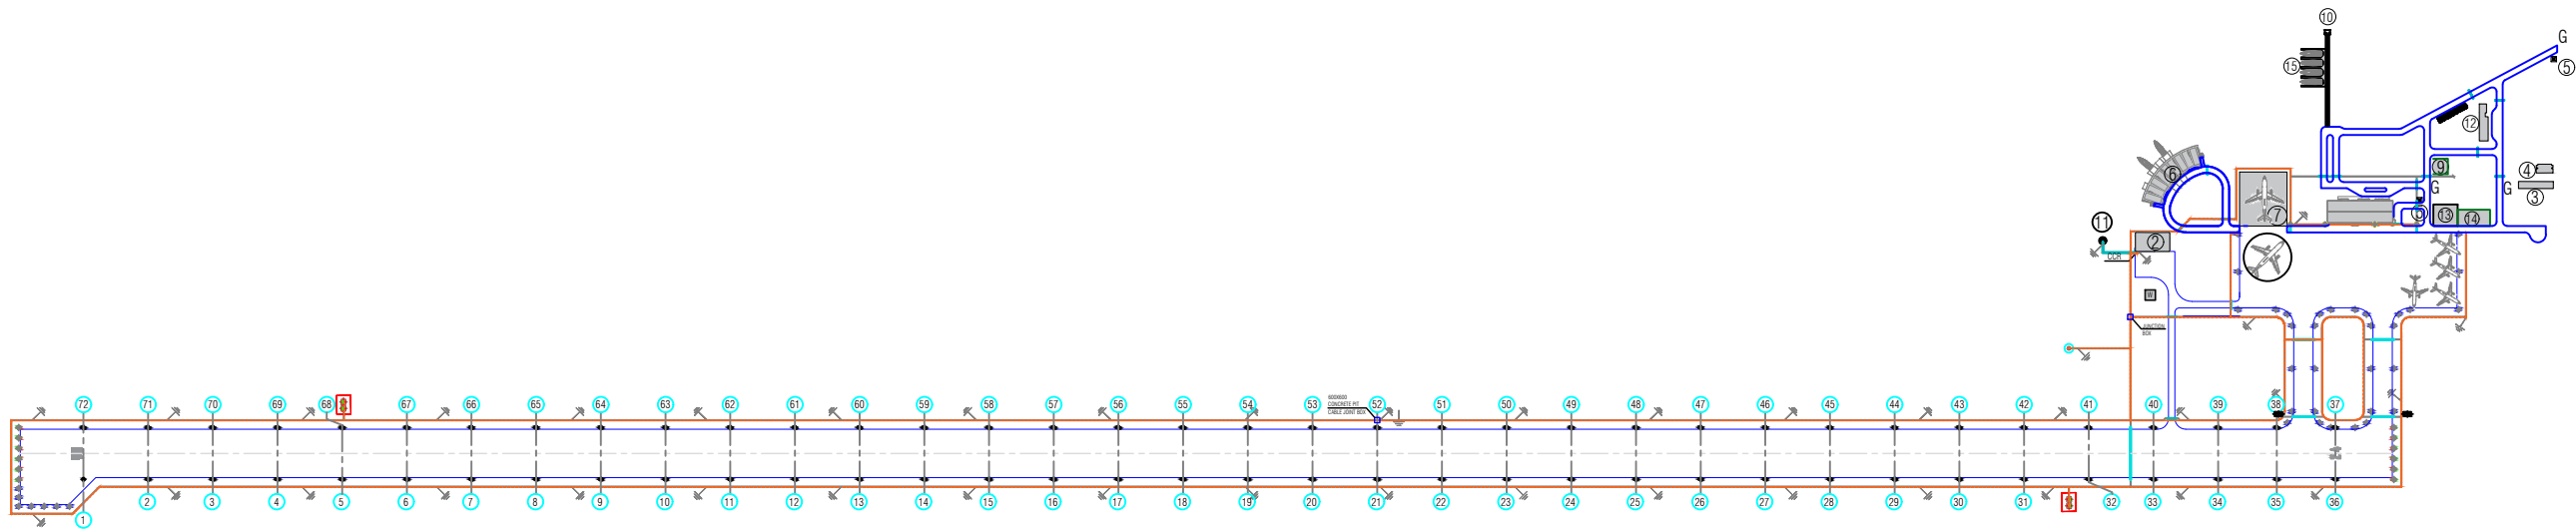


AS-BUILT

EARTH CABLE LAYOUT

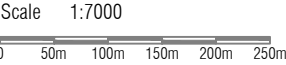

| SYMBOL | DESCRIPTION                                      | SIZE               | LENGTH   |
|--------|--|--------------------|----------|
|        | EARTH CABLE                                      | 16 MM <sup>2</sup> | 10,000 M |
|        | COUNTERPOISE EARTH ROD<br>PLACED DIST < 125M C/C | -                  | 46 NOS   |
|        | SERVICE DUCT                                     | -                  | -        |

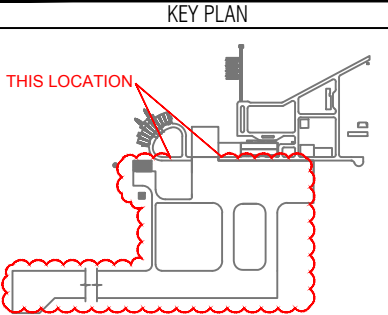

|                              |      |
|------------------------------|------|
| 19-08-2019                   |      |
| M. PRABHU                    | DATE |
| CONSULTANT SIGNATURE         |      |
| APPROVAL OF REGIONAL AIRPORT |      |
| MALDIVES                     | DATE |

| REFERENCE CONSTRUCTION DRAWING NUMBER | REV |
|---------------------------------------|-----|
| T1713-TOS-33000-CV-DW-0018            | A4  |

| AS-BUILT    |            |
|-------------|------------|
| Description | Date       |
| AS-BUILT    | 19/08/2019 |

DRAWING STATUS ☒ APPROVED ☐ REJECTED

N. MAAFARU AIRPORT  
AIRFIELD LIGHTING &  
LANDING AIDS

Drawing Title:  
EARTH CABLE LAYOUT

Employer:  
REGIONAL AIRPORTS  
MINISTRY OF TOURISM





Funder:  
  
صندوق أبوظبي للتنمية  
ABU DHABI FUND FOR DEVELOPMENT

Contractor:  
  
TUFF

Consultant:  
  
HOCHTIEF  
INDIA

Supervision & Management Consultant:  
  
ARMSTRONG

|                                   |                |                 |
|-----------------------------------|----------------|-----------------|
| Issue: AB                         | Date: AUG-2019 | Pages: 18 of 38 |
| Scale: N.T.S                      | Paper: A3      |                 |
| DWG #: T1713-TOS-33000-CV-DW-0018 |                |                 |

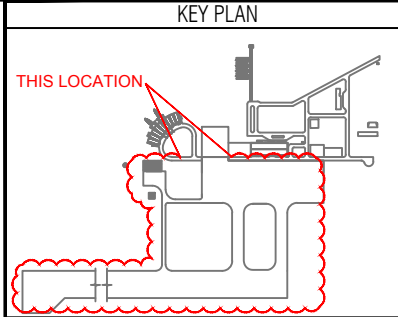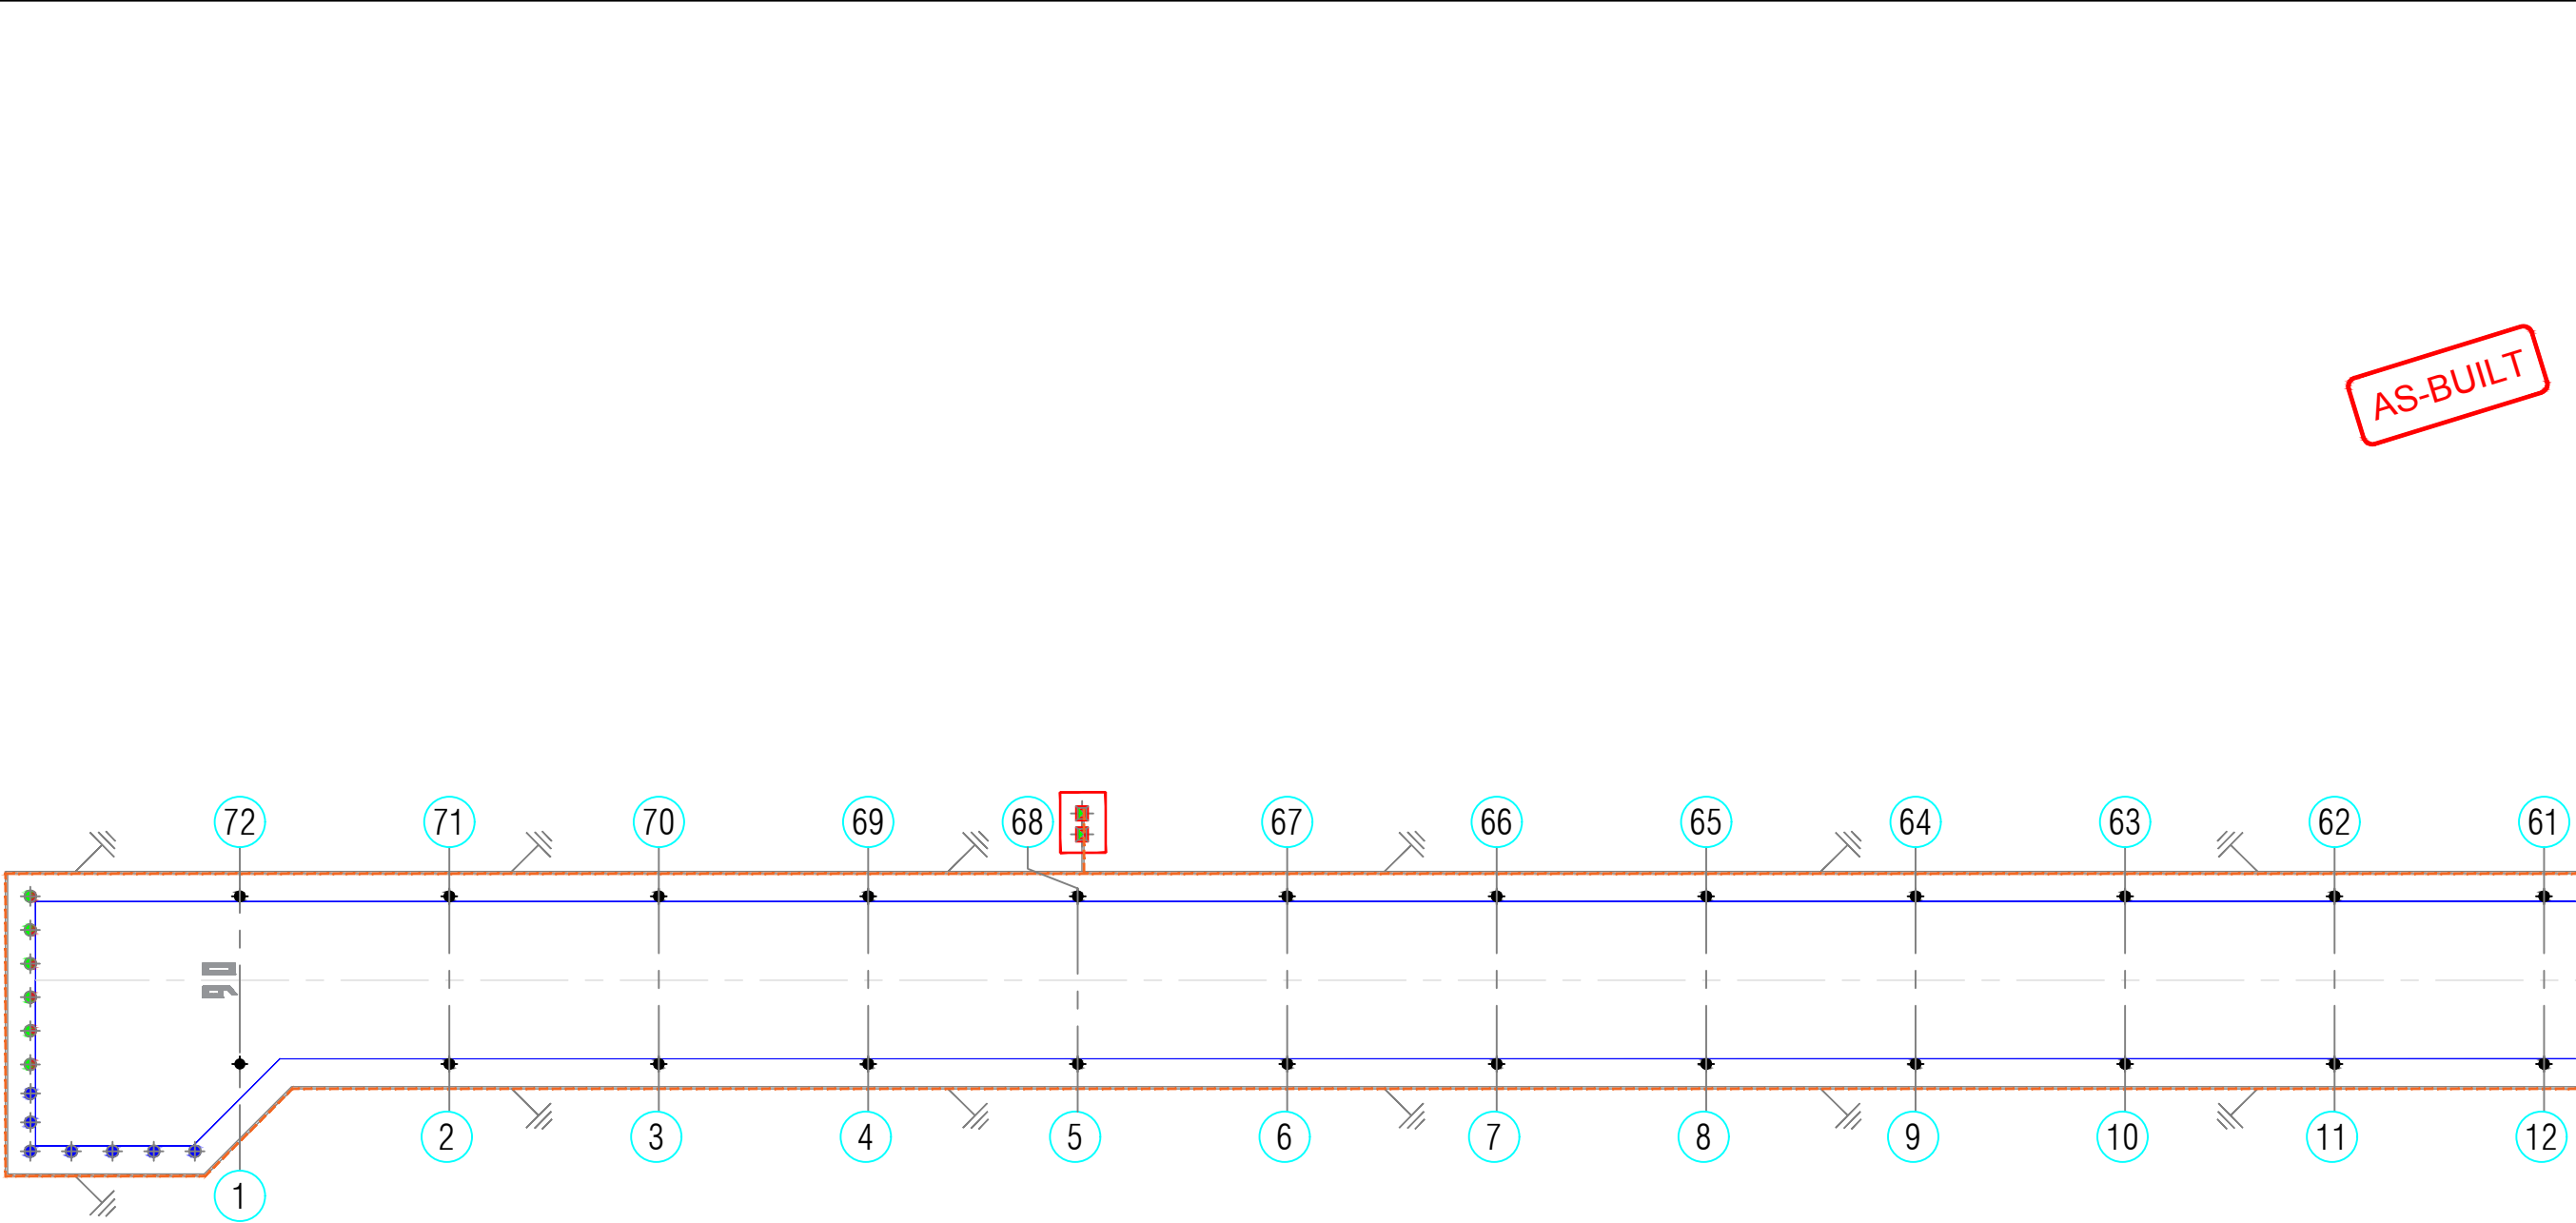

19-08-2019

DATE

M. PRABHU

CONSULTANT SIGNATURE

APPROVAL OF REGIONAL AIRPORT

MALDIVES

DATE

| REFERENCE CONSTRUCTION DRAWING NUMBER | REV |
|---------------------------------------|-----|
| T1713-TOS-33000-CV-DW-0019            | A4  |

| AS-BUILT    |            |
|-------------|------------|
| Description | Date       |
| AS-BUILT    | 19/08/2019 |

DRAWING STATUS

☒ APPROVED

☐ REJECTED

N. MAAFARU AIRPORT

AIRFIELD LIGHTING & LANDING AIDS

Drawing Title:

EARTH CABLE LAYOUT  
(GRID 1~12 AND 61~72)

Employer:

REGIONAL AIRPORTS  
MINISTRY OF TOURISM

Funder:

  
صندوق أبوظبي للتنمية  
ABU DHABI FUND FOR DEVELOPMENT

Contractor:

 TUFF

Consultant:

 HOCHTIEF  
INDIA

Supervision & Management Consultant:

 ARMSTRONG

Issue: AB







 


Date: AUG-2019




Pages: 19 of 38

Scale: N.T.S

Paper: A3


DWG #: T1713-TOS-33000-CV-DW-0019

| SYMBOL  | DESCRIPTION          | LOCATION                          |
|---|----------------------|-----------------------------------|
|  | EDGE LIGHTS          | RUNWAY EDGE                       |
|  | EDGE LIGHTS          | TAXIWAY, APRON & TURNING PAD EDGE |
|  | END LIGHTS           | RUNWAY END                        |
|  | INSET LIGHTS         | RUNWAY (GRID-1)                   |
|  | FLOOD LIGHTS/ MAST   | APRON LANDSIDE EDGE               |
|  | AAPI                 | 300M FROM RUNWAY PHYSICAL ENDS    |
|  | WIND CONE / WDI      | AS SHOWN                          |
|  | CONNECTION FROM CCR3 | AS SHOWN                          |
|  | CONNECTION FROM CCR2 | AS SHOWN                          |


| SYMBOL  | DESCRIPTION                                    | SIZE               | LENGTH   |
|---|--|--------------------|----------|
|  | EARTH CABLE                                    | 16 MM <sup>2</sup> | 10,000 M |
|  | COUNTERPOISE EARTH ROD<br>PLACED DIST<125M C/C | -                  | 46 NOS   |
|  | SERVICE DUCT                                   | -                  | -        |

EARTH CABLE LAYOUT (GRID 1~12 AND 61~72)


Scale 1:2000

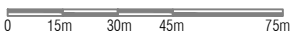



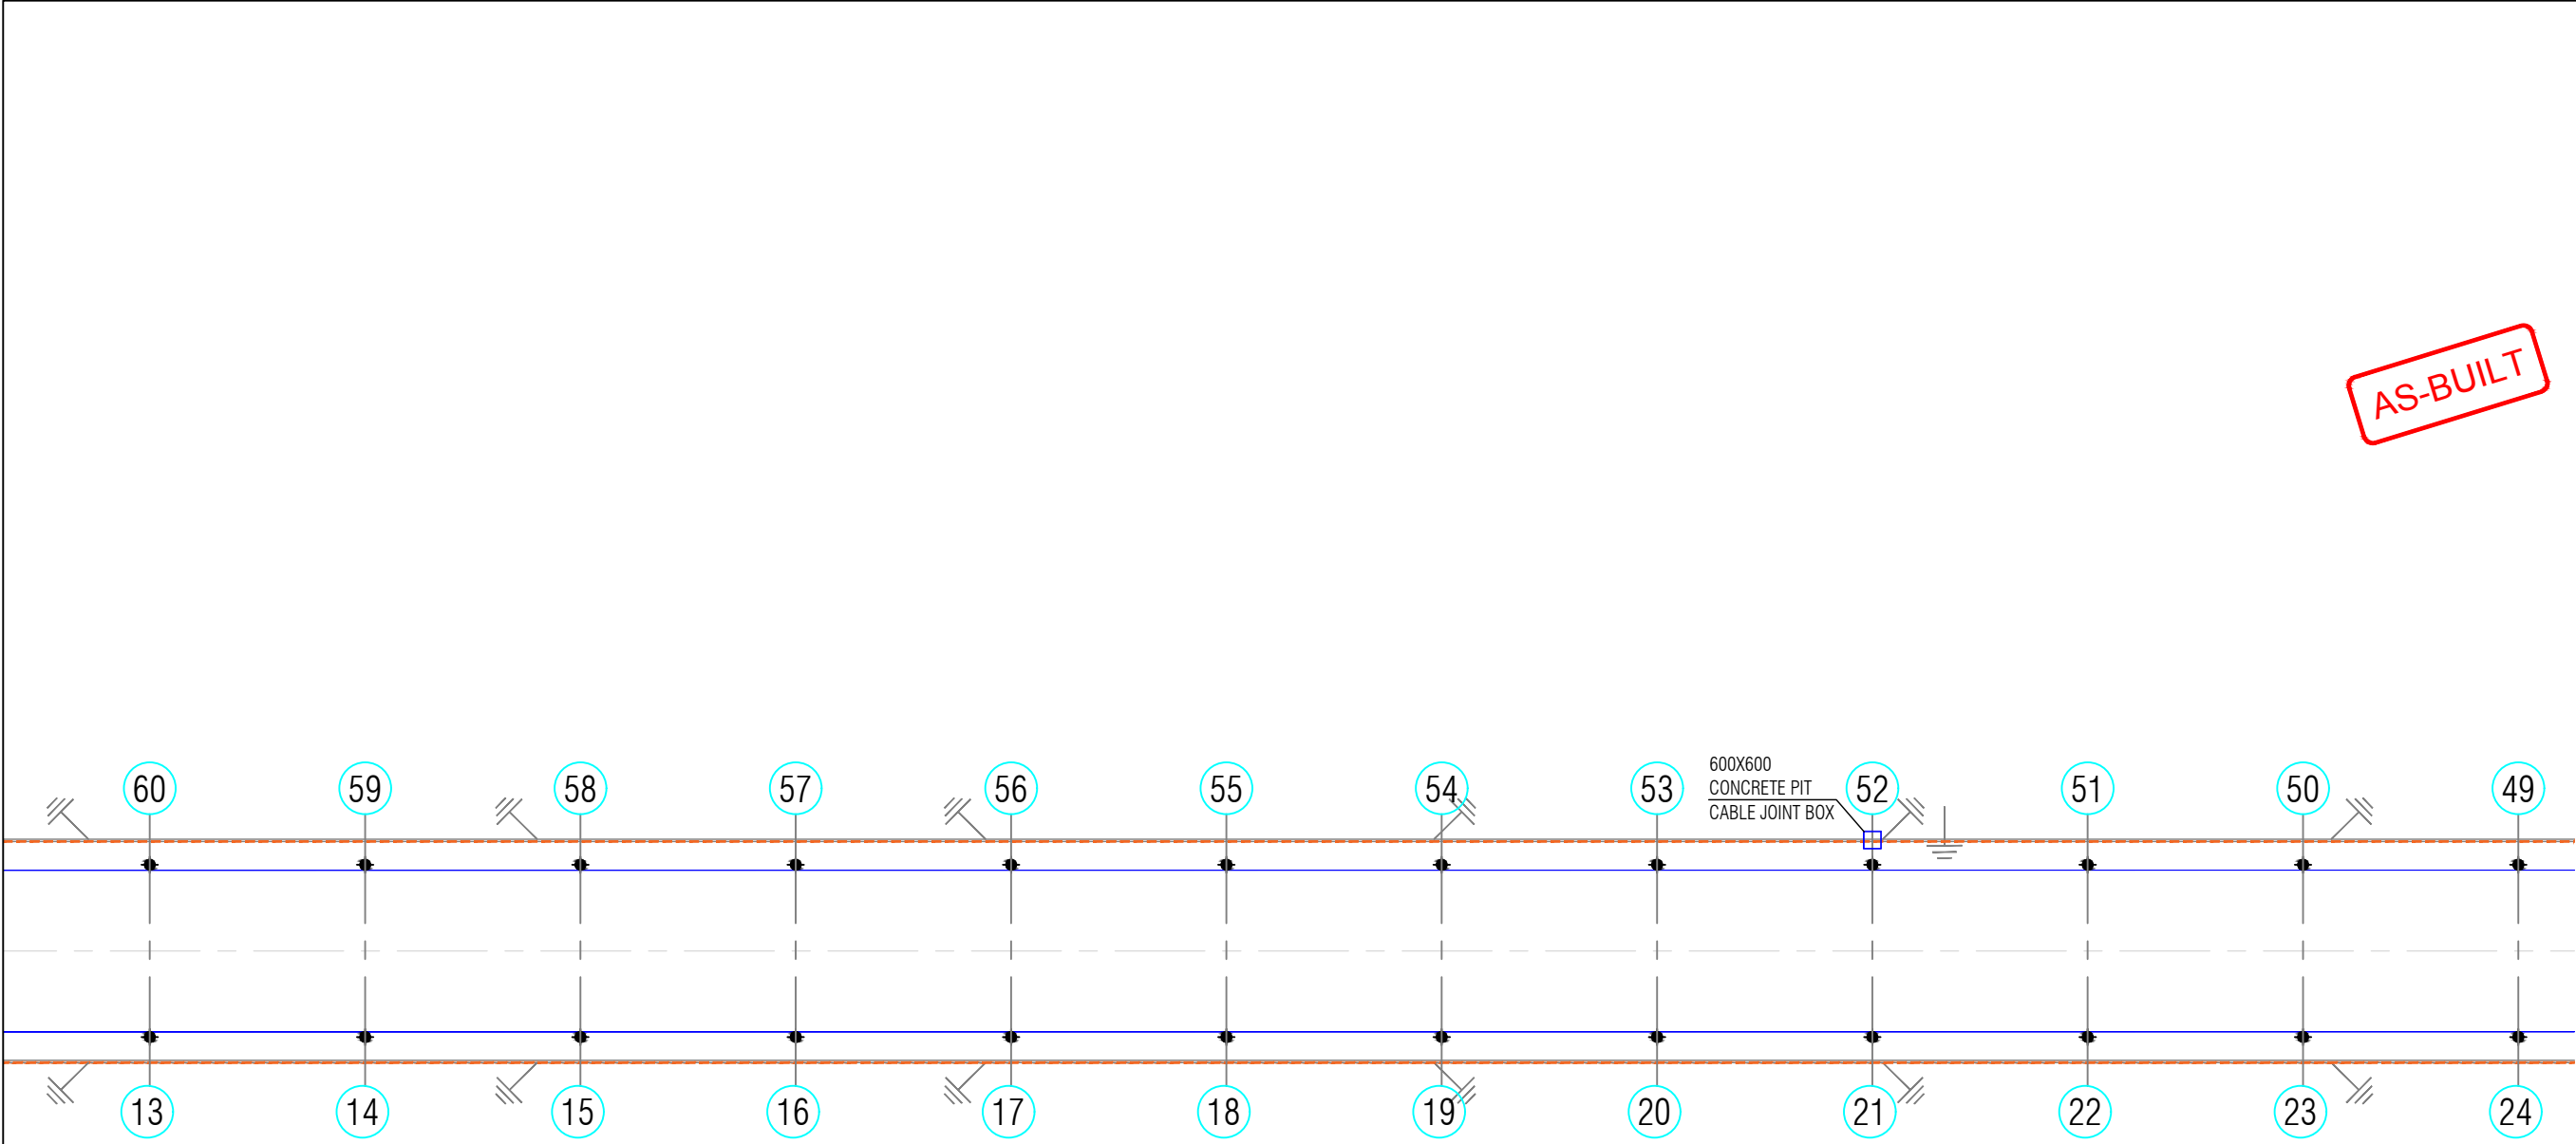

AS-BUILT

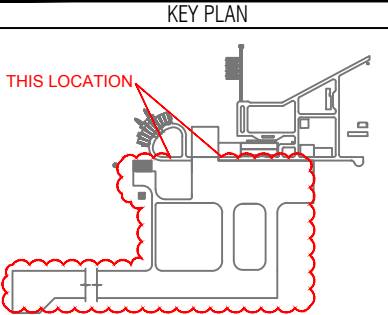

|                              |      |
|------------------------------|------|
| 19-08-2019                   |      |
| M. PRABHU                    | DATE |
| CONSULTANT SIGNATURE         |      |
| APPROVAL OF REGIONAL AIRPORT |      |
| MALDIVES                     |      |
| DATE                         |      |

| REFERENCE CONSTRUCTION DRAWING NUMBER | REV |
|---------------------------------------|-----|
| T1713-TOS-33000-CV-DW-0020            | A4  |

| AS-BUILT    |            |
|-------------|------------|
| Description | Date       |
| AS-BUILT    | 19/08/2019 |

DRAWING STATUS ☒ APPROVED ☐ REJECTED

### N. MAAFARU AIRPORT

AIRFIELD LIGHTING & LANDING AIDS

Drawing Title:  
EARTH CABLE LAYOUT  
(GRID 13~24 AND 49~60)

Employer:  
REGIONAL AIRPORTS  
MINISTRY OF TOURISM










Funder:  
  
صندوق أبوظبي للتنمية  
ABU DHABI FUND FOR DEVELOPMENT




Contractor:  
 TUFF

Consultant:  
 HOCHTIEF  
INDIA

Supervision & Management Consultant:  
 ARMSTRONG

|                                   |                |                 |
|-----------------------------------|----------------|-----------------|
| Issue: AB                         | Date: AUG-2019 | Pages: 20 of 38 |
| Scale: N.T.S                      | Paper: A3      |                 |
| DWG #: T1713-TOS-33000-CV-DW-0020 |                |                 |

| SYMBOL  | DESCRIPTION          | LOCATION                          |
|---|----------------------|-----------------------------------|
|  | EDGE LIGHTS          | RUNWAY EDGE                       |
|  | EDGE LIGHTS          | TAXIWAY, APRON & TURNING PAD EDGE |
|  | END LIGHTS           | RUNWAY END                        |
|  | INSET LIGHTS         | RUNWAY (GRID-1)                   |
|  | FLOOD LIGHTS/ MAST   | APRON LANDSIDE EDGE               |
|  | APAPI                | 300M FROM RUNWAY PHYSICAL ENDS    |
|  | WIND CONE / WDI      | AS SHOWN                          |
|  | CONNECTION FROM CCR3 | AS SHOWN                          |
|  | CONNECTION FROM CCR2 | AS SHOWN                          |


| SYMBOL  | DESCRIPTION                                      | SIZE               | LENGTH   |
|---|--|--------------------|----------|
|  | EARTH CABLE                                      | 16 MM <sup>2</sup> | 10,000 M |
|  | COUNTERPOISE EARTH ROD<br>PLACED DIST < 125M C/C | -                  | 46 NOS   |
|  | SERVICE DUCT                                     | -                  | -        |

### EARTH CABLE LAYOUT (GRID 13~24 AND 49~60)

Scale 1:2000





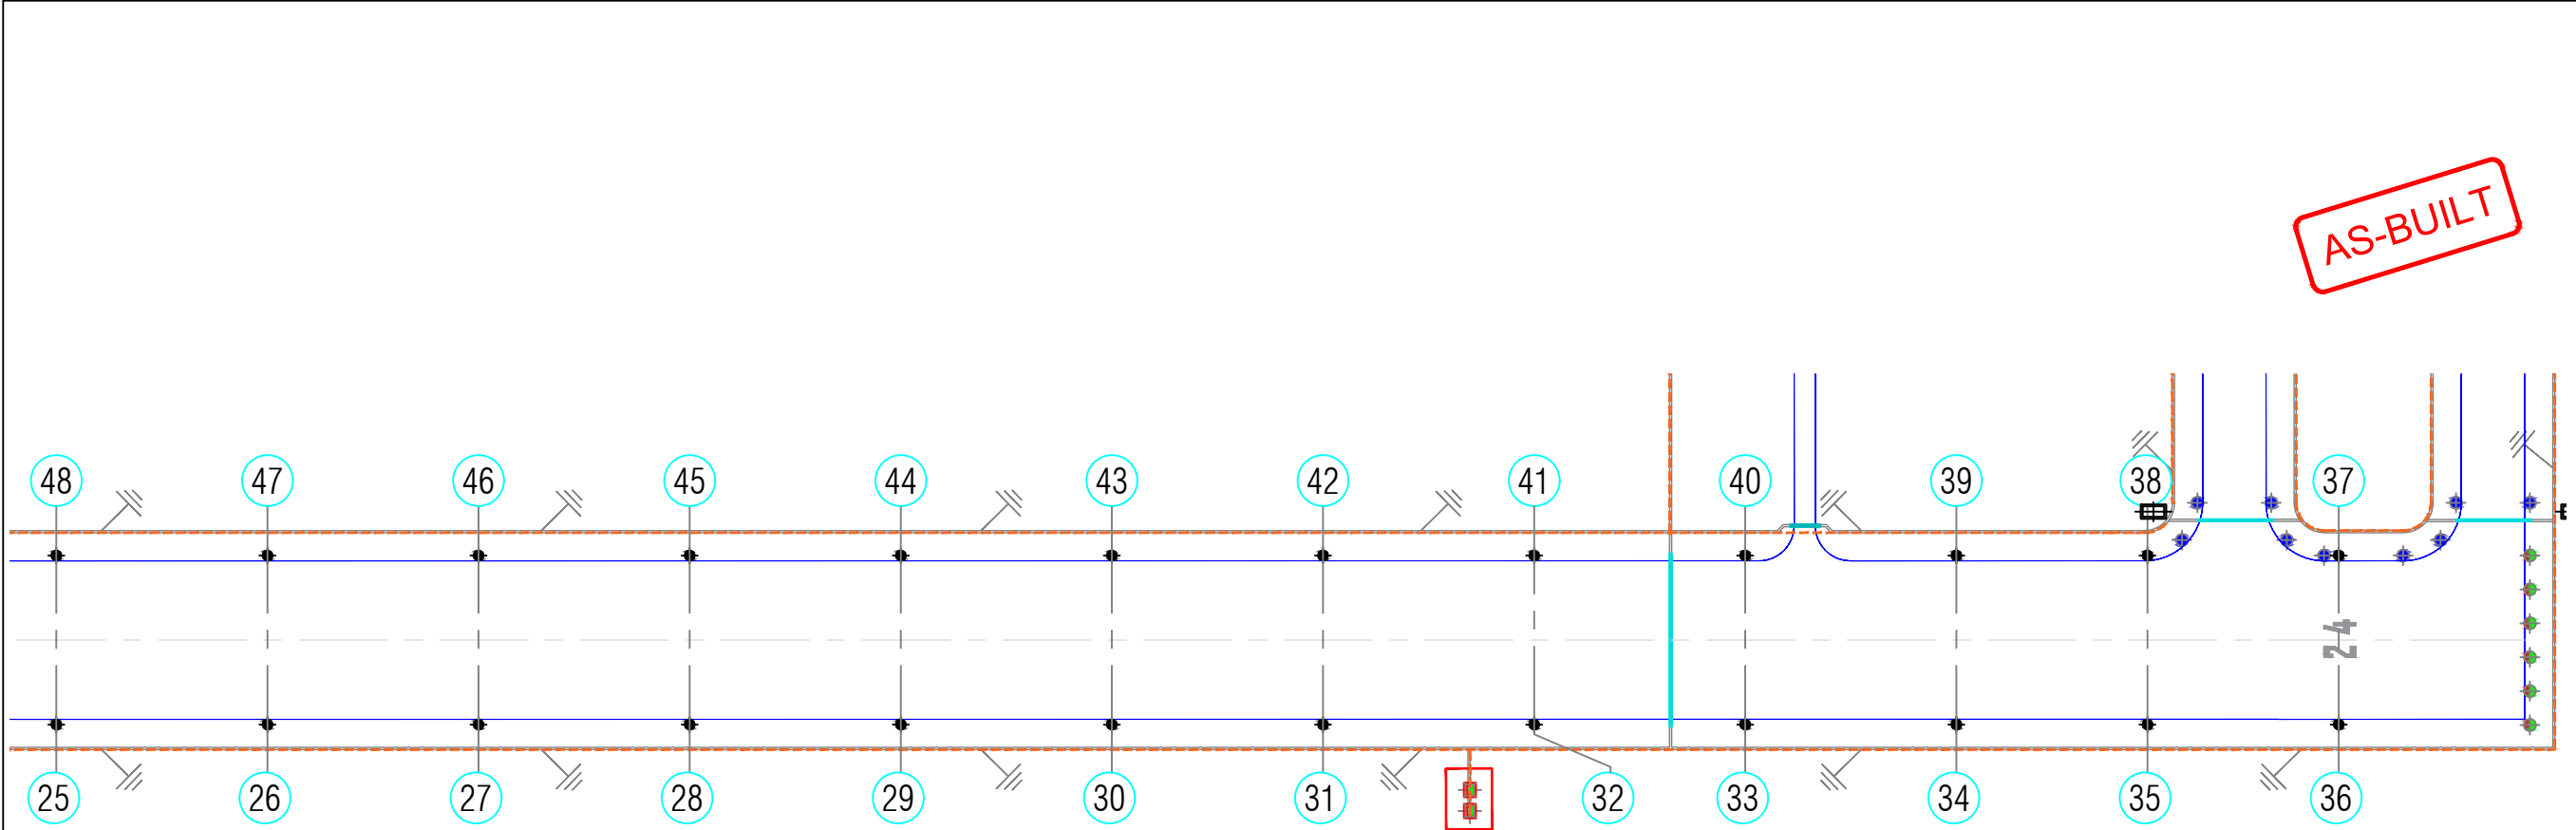

EARTH CABLE LAYOUT (GRID 25~48)

Scale 1:2000



| SYMBOL | DESCRIPTION          | LOCATION                          |
|--------|----------------------|-----------------------------------|
|        | EDGE LIGHTS          | RUNWAY EDGE                       |
|        | EDGE LIGHTS          | TAXIWAY, APRON & TURNING PAD EDGE |
|        | END LIGHTS           | RUNWAY END                        |
|        | INSET LIGHTS         | RUNWAY (GRID-1)                   |
|        | FLOOD LIGHTS/ MAST   | APRON LANDSIDE EDGE               |
|        | APAPI                | 300M FROM RUNWAY PHYSICAL ENDS    |
|        | WIND CONE / WDI      | AS SHOWN                          |
|        | CONNECTION FROM CCR3 | AS SHOWN                          |
|        | CONNECTION FROM CCR2 | AS SHOWN                          |

| SYMBOL | DESCRIPTION                                      | SIZE               | LENGTH   |
|--------|--|--------------------|----------|
|        | EARTH CABLE                                      | 16 MM <sup>2</sup> | 10,000 M |
|        | COUNTERPOISE EARTH ROD<br>PLACED DIST < 125M C/C | -                  | 46 NOS   |
|        | SERVICE DUCT                                     | -                  | -        |

KEY PLAN

M. PRABHU  
CONSULTANT SIGNATURE

19-08-2019  
DATE

APPROVAL OF REGIONAL AIRPORT  
MALDIVES

DATE

REFERENCE CONSTRUCTION DRAWING NUMBER

REV

T1713-TOS-33000-CV-DW-0021

A4

AS-BUILT

Description

Date

AS-BUILT

19/08/2019

DRAWING STATUS

APPROVED

REJECTED

N. MAAFARU AIRPORT

AIRFIELD LIGHTING &  
LANDING AIDS

Drawing Title:

EARTH CABLE LAYOUT (GRID 25~48)

Employer:

REGIONAL AIRPORTS  
MINISTRY OF TOURISM

Funder:

صندوق أبوظبي للتنمية  
ABU DHABI FUND FOR DEVELOPMENT

Contractor:

TUFF

Consultant:

HOCHTIEF  
INDIA

Supervision & Management Consultant:

ARMSTRONG

Issue: AB


Date: AUG-2019

Pages: 21 of 38

Scale: N.T.S


Paper: A3

DWG #: T1713-TOS-33000-CV-DW-0021

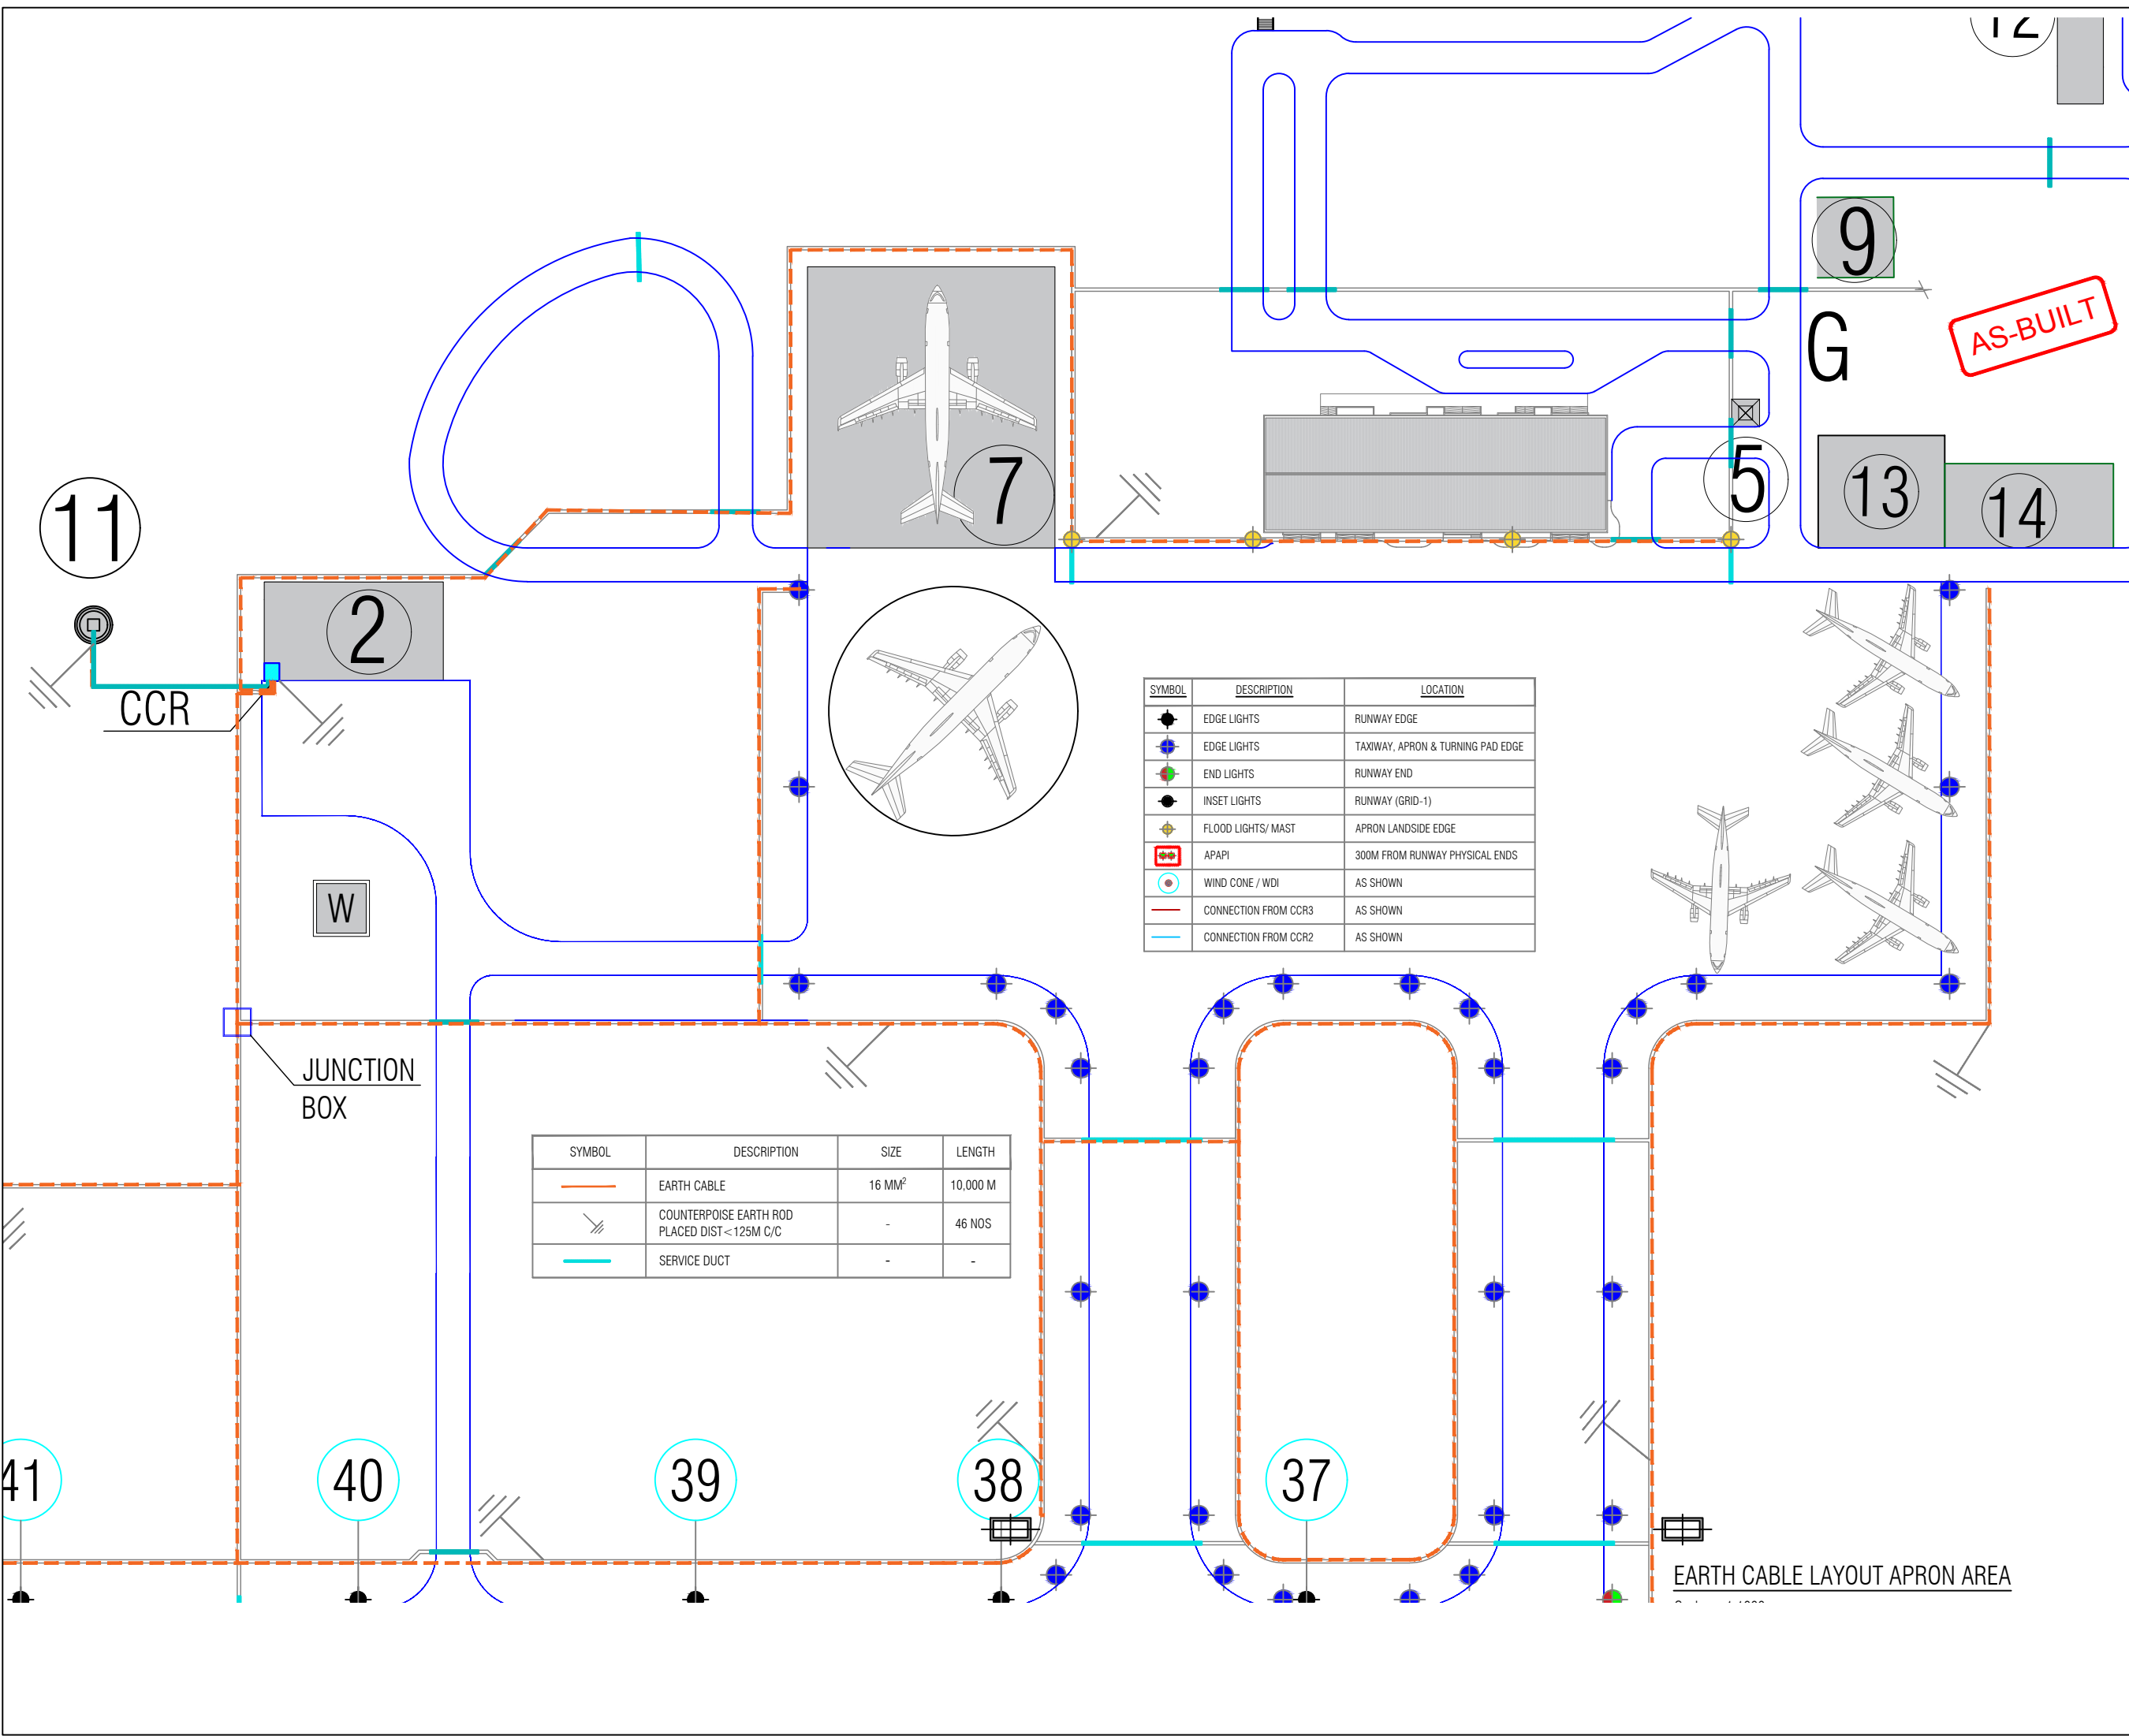

| SYMBOL | DESCRIPTION                                      | SIZE               | LENGTH   |
|--------|--|--------------------|----------|
|        | EARTH CABLE                                      | 16 MM <sup>2</sup> | 10,000 M |
|        | COUNTERPOISE EARTH ROD<br>PLACED DIST < 125M C/C | -                  | 46 NOS   |
|        | SERVICE DUCT                                     | -                  | -        |

| SYMBOL | DESCRIPTION          | LOCATION                          |
|--------|----------------------|-----------------------------------|
|        | EDGE LIGHTS          | RUNWAY EDGE                       |
|        | EDGE LIGHTS          | TAXIWAY, APRON & TURNING PAD EDGE |
|        | END LIGHTS           | RUNWAY END                        |
|        | INSET LIGHTS         | RUNWAY (GRID-1)                   |
|        | FLOOD LIGHTS/ MAST   | APRON LANDSIDE EDGE               |
|        | APAPI                | 300M FROM RUNWAY PHYSICAL ENDS    |
|        | WIND CONE / WDI      | AS SHOWN                          |
|        | CONNECTION FROM CCR3 | AS SHOWN                          |
|        | CONNECTION FROM CCR2 | AS SHOWN                          |

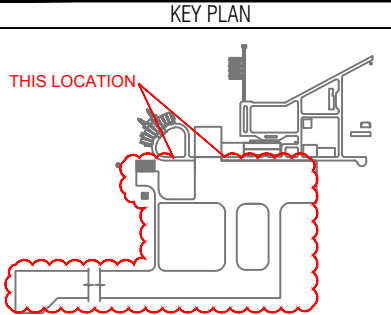

19-08-2019

M. PRABHU

CONSULTANT SIGNATURE

DATE

APPROVAL OF REGIONAL AIRPORT  
MALDIVES

DATE

REFERENCE CONSTRUCTION DRAWING NUMBER

REV

T1713-TOS-33000-CV-DW-0022

A4

| AS-BUILT    |            |
|-------------|------------|
| Description | Date       |
| AS-BUILT    | 19/08/2019 |

DRAWING STATUS

☒ APPROVED

☐ REJECTED

N. MAAFARU AIRPORT

AIRFIELD LIGHTING &  
LANDING AIDS

Drawing Title:

EARTH CABLE LAYOUT APRON AREA

Employer:

REGIONAL AIRPORTS  
MINISTRY OF TOURISM

Funder:

صندوق أبوظبي للتنمية  
ABU DHABI FUND FOR DEVELOPMENT

Contractor:

TUFF

Consultant:


HOCHTIEF  
INDIA

Supervision & Management Consultant:

ARMSTRONG


| SYMBOL | DESCRIPTION  | SIZE                            |
|--------|--|---------------------------------|
|        | CCR TO WINDCONE  | 2.5-3MM <sup>2</sup> (3 CORE)   |
|        | CCR TO TRANSFORMER 24 END (PRIMARY CABLE) - CIRCUIT CS1 CONNECTED TO CCR 3 | 6 MM <sup>2</sup> (SINGLE CORE) |
|        | TRANSFORMER 24 END TO APAPI- 24 END (SECONDARY CABLE)                      | 2.5 MM <sup>2</sup> (2 CORE)    |
|        | CCR TO TRANSFORMER 06 END (PRIMARY CABLE)- CIRCUIT CS2 CONNECTED TO CCR 3  | 6 MM <sup>2</sup> (SINGLE CORE) |
|        | TRANSFORMER 24 END TO APAPI- 06 END (SECONDARY CABLE)                      | 2.5 MM <sup>2</sup> (2 CORE)    |
|        | SERVICE DUCT   | -                               |

| SYMBOL | DESCRIPTION          | LOCATION                          |
|--------|----------------------|-----------------------------------|
|        | EDGE LIGHTS          | RUNWAY EDGE                       |
|        | EDGE LIGHTS          | TAXIWAY, APRON & TURNING PAD EDGE |
|        | END LIGHTS           | RUNWAY END                        |
|        | INSET LIGHTS         | RUNWAY (GRID-1)                   |
|        | FLOOD LIGHTS/ MAST   | APRON LANDSIDE EDGE               |
|        | APAPI                | 300M FROM RUNWAY PHYSICAL ENDS    |
|        | WIND CONE / WDI      | AS SHOWN                          |
|        | CONNECTION FROM CCR3 | AS SHOWN                          |
|        | CONNECTION FROM CCR2 | AS SHOWN                          |

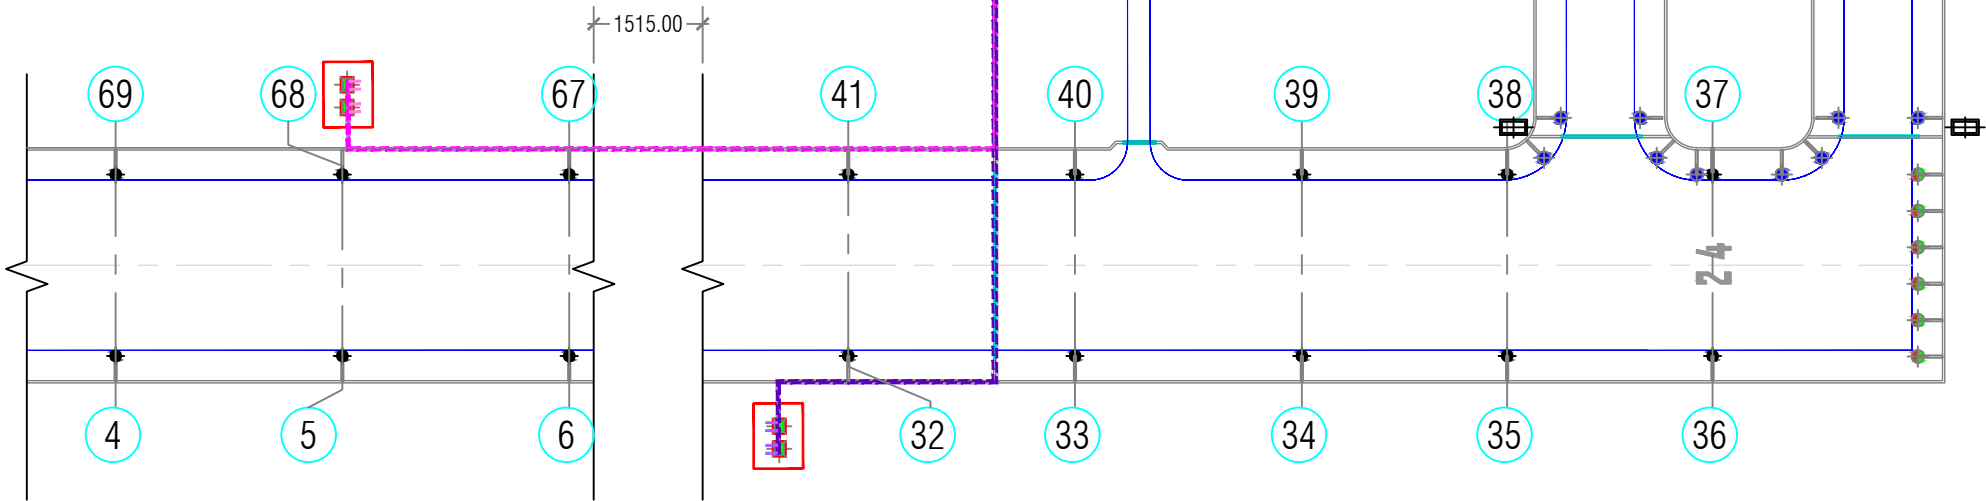

CABLE ROUTE- CCR TO WINDCONE & APAPI

Scale 1:2000  
0 15m 30m 45m 75m

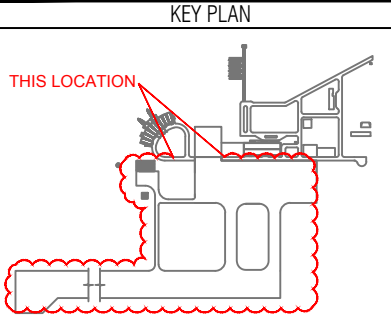

19-08-2019  
M. PRABHU  
CONSULTANT SIGNATURE  
DATE

APPROVAL OF REGIONAL AIRPORT  
MALDIVES  
DATE

REFERENCE CONSTRUCTION DRAWING NUMBER  
T1713-TOS-33000-CV-DW-0023  
REV  
A4

AS-BUILT  
Description  
Date  
AS-BUILT  
19/08/2019

DRAWING STATUS  
APPROVED  
REJECTED  
N. MAAFARU AIRPORT  
AIRFIELD LIGHTING &  
LANDING AIDS

Drawing Title:  
CABLE ROUTE-  
PH TO CCR & CCR TO WINDCONE & APAPI

Employer:  
REGIONAL AIRPORTS  
MINISTRY OF TOURISM



Funder:  
ABU DHABI FUND FOR DEVELOPMENT

Contractor:  
TUFF

Consultant:  
HOCHTIEF  
INDIA

Supervision & Management Consultant:  
ARMSTRONG

Issue: AB  
Date: AUG-2019  
Pages: 23 of 38  
Scale: N.T.S  
Paper: A3  
DWG #: T1713-TOS-33000-CV-DW-0023

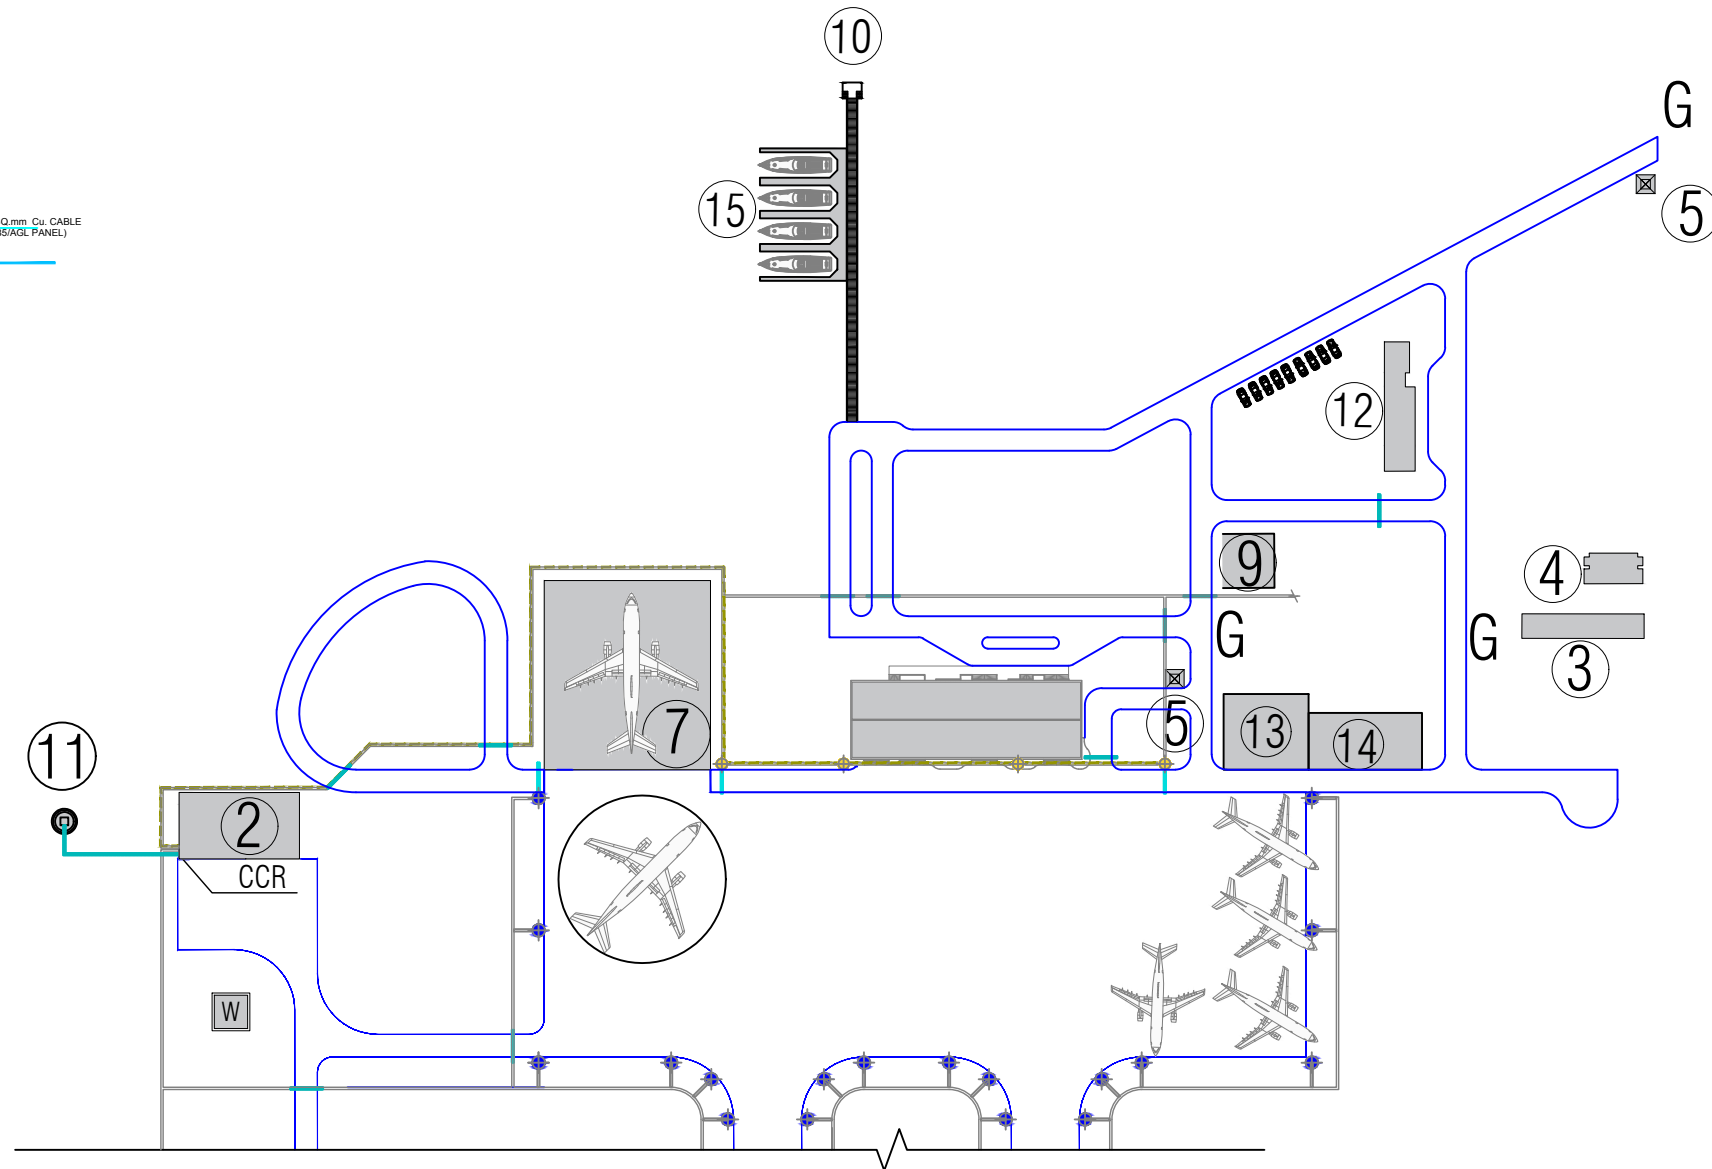
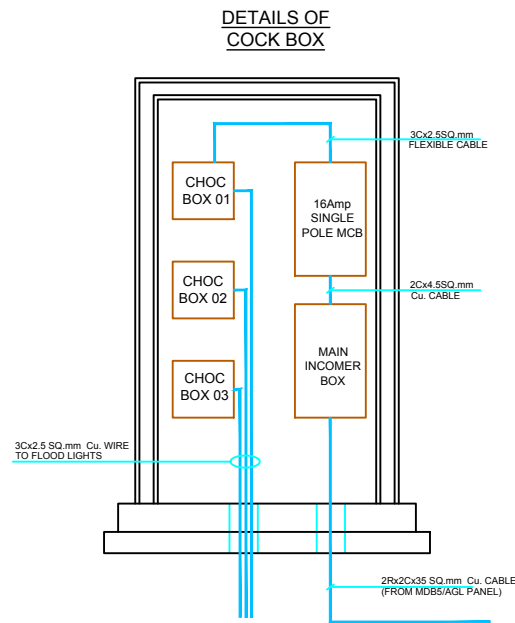


| SYMBOL | DESCRIPTION          | LOCATION                          |
|--------|----------------------|-----------------------------------|
|        | EDGE LIGHTS          | RUNWAY EDGE                       |
|        | EDGE LIGHTS          | TAXIWAY, APRON & TURNING PAD EDGE |
|        | END LIGHTS           | RUNWAY END                        |
|        | INSET LIGHTS         | RUNWAY (GRID-1)                   |
|        | FLOOD LIGHTS/ MAST   | APRON LANDSIDE EDGE               |
|        | APAPI                | 300M FROM RUNWAY PHYSICAL ENDS    |
|        | WIND CONE / WDI      | AS SHOWN                          |
|        | CONNECTION FROM CCR3 | AS SHOWN                          |
|        | CONNECTION FROM CCR2 | AS SHOWN                          |

| SYMBOL | DESCRIPTION       | SIZE                         | LENGTH |
|--------|-------------------|------------------------------|--------|
|        | CCR TO APRON MAST | 35 MM <sup>2</sup> ( 4 CORE) | 460 M  |
|        | SERVICE DUCT      | -                            | -      |

## CABLE ROUTE- CCR TO APRON MASTS

Scale 1:2000

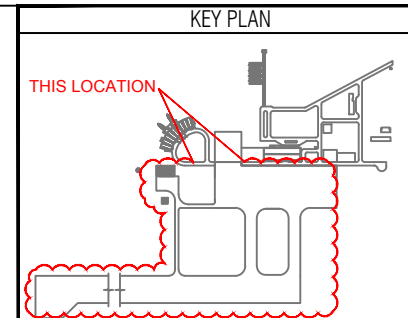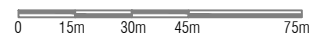

M. PRABHU  
CONSULTANT SIGNATURE

19-08-2019  
DATE

APPROVAL OF REGIONAL AIRPORT  
MALDIVES

DATE

| REFERENCE CONSTRUCTION DRAWING NUMBER | REV |
|---------------------------------------|-----|
| T1713-TOS-33000-CV-DW-0024            | A4  |

| AS-BUILT    |            |
|-------------|------------|
| Description | Date       |
| AS-BUILT    | 19/08/2019 |

DRAWING STATUS ☒ APPROVED ☐ REJECTED

## N. MAAFARU AIRPORT

AIRFIELD LIGHTING & LANDING AIDS

Drawing Title:  
CABLE ROUTE- CCR TO APRON MASTS

Employer:  
REGIONAL AIRPORTS  
MINISTRY OF TOURISM

Funder:  
  
صندوق أبوظبي للتنمية  
ABU DHABI FUND FOR DEVELOPMENT

Contractor:

Consultant:

Supervision & Management Consultant:

Issue: AB Date: AUG-2019 Pages: 24 of 38


Scale: N.T.S. Paper: A3

DWG #: T1713-TOS-33000-CV-DW-0024

REMOVED


AS-BUILT

| SYMBOL | DESCRIPTION          | LOCATION                          |
|--------|----------------------|-----------------------------------|
|        | EDGE LIGHTS          | RUNWAY EDGE                       |
|        | EDGE LIGHTS          | TAXIWAY, APRON & TURNING PAD EDGE |
|        | END LIGHTS           | RUNWAY END                        |
|        | INSET LIGHTS         | RUNWAY (GRID-1)                   |
|        | FLOOD LIGHTS/ MAST   | APRON LANDSIDE EDGE               |
|        | APAPI                | 300M FROM RUNWAY PHYSICAL ENDS    |
|        | WIND CONE / WDI      | AS SHOWN                          |
|        | CONNECTION FROM CCR3 | AS SHOWN                          |
|        | CONNECTION FROM CCR2 | AS SHOWN                          |

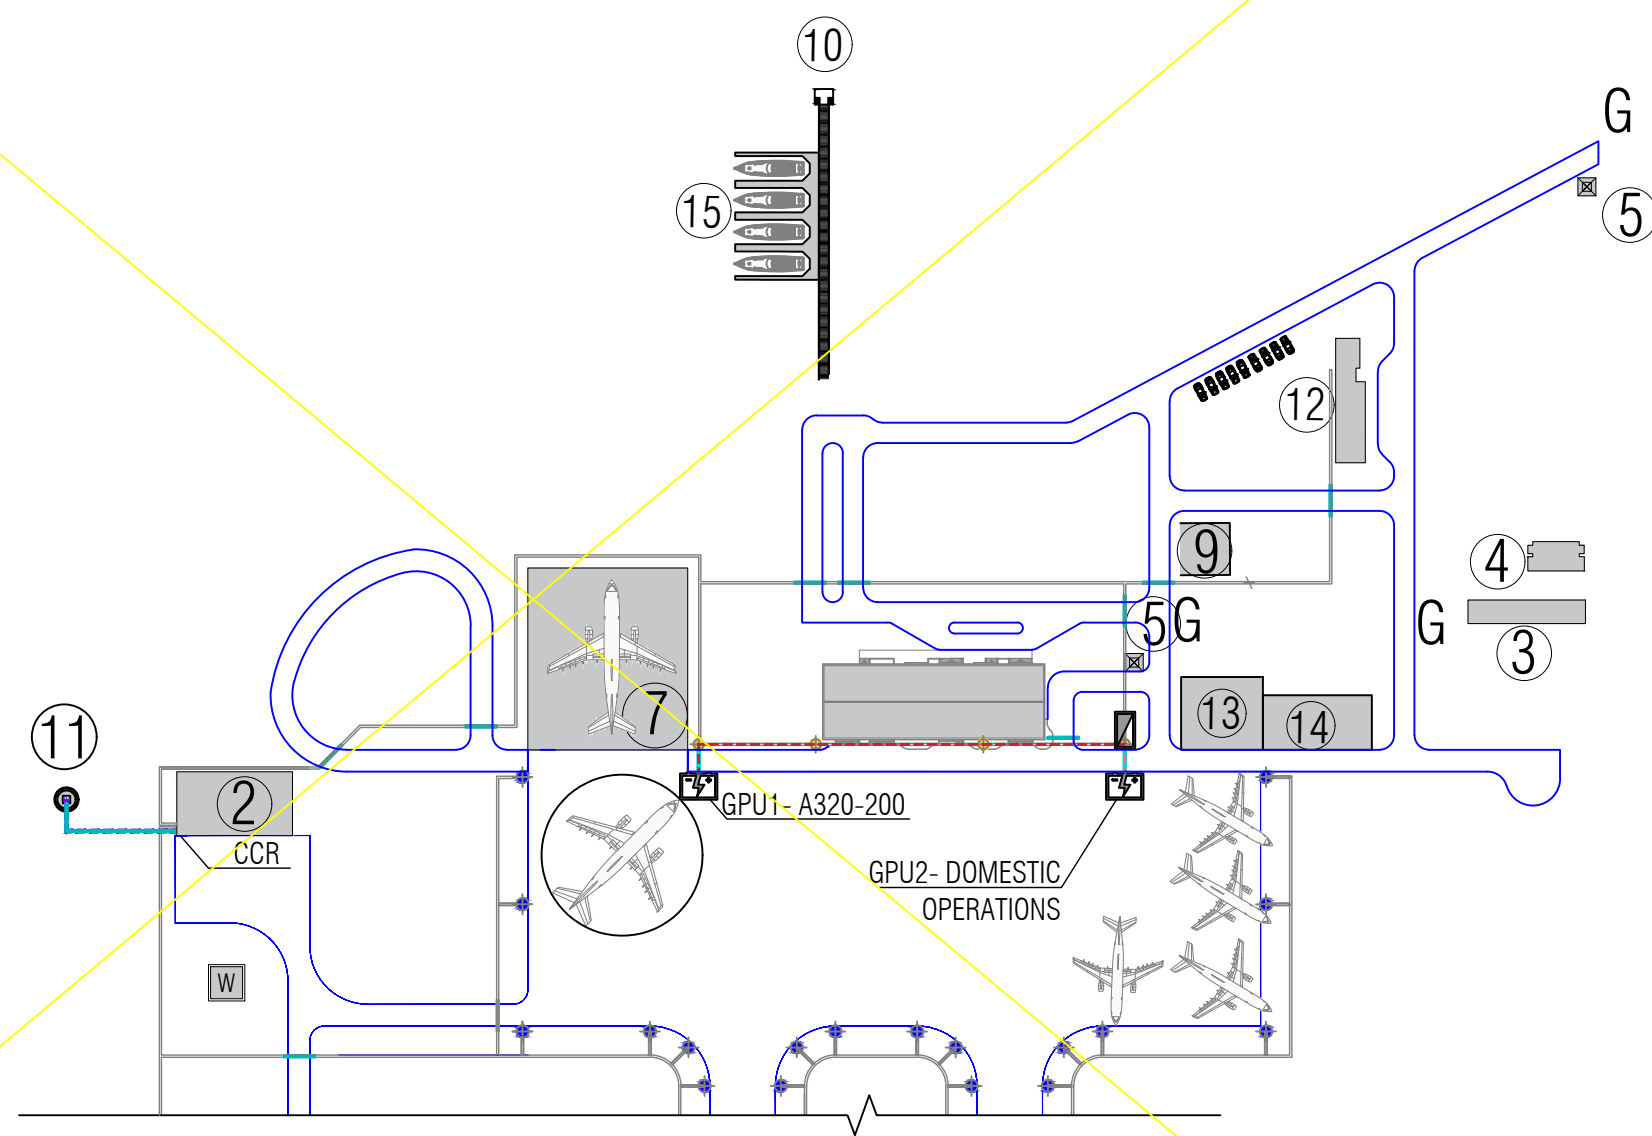

| SYMBOL | DESCRIPTION                           | SIZE                | LENGTH |
|--------|---------------------------------------|---------------------|--------|
|        | MDB 10 TO GPU 1 (A320-200)            | 100 MM <sup>2</sup> | 140 M  |
|        | MDB 10 TO GPU 2 (DOMESTIC OPERATIONS) | 40 MM <sup>2</sup>  | 30 M   |
|        | CCR - CONTROL TOWER (POWER CABLE)     | 25MM <sup>2</sup>   | 55 M   |
|        | CCR - CONTROL TOWER (DATA CABLE)      | CAT 5 OR CAT 6      | 55 M   |
|        | GROUND POWER UNIT (GPU)               | -                   | -      |
|        | DISTRIBUTION BOX (MDB 10)             | -                   | -      |
|        | SERVICE DUCT                          | -                   | -      |

CABLE ROUTE- MDB 10 TO GPU  
Scale 1:2000

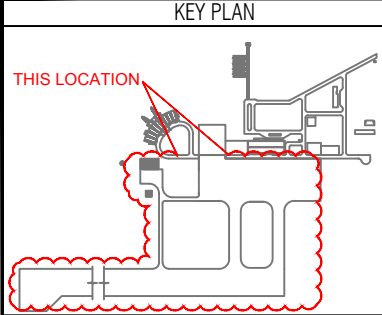

| KEY PLAN                              |            |
|---------------------------------------|------------|
|                                       |            |
| 19-08-2019                            |            |
| M. PRABHU                             | DATE       |
| CONSULTANT SIGNATURE                  |            |
| APPROVAL OF REGIONAL AIRPORT          |            |
| MALDIVES                              |            |
| DATE                                  |            |
| REFERENCE CONSTRUCTION DRAWING NUMBER | REV        |
| T1713-TOS-33000-CV-DW-0025            | A4         |
| AS-BUILT                              |            |
| Description                           | Date       |
| AS-BUILT                              | 19/08/2019 |
| DRAWING STATUS                        | APPROVED   |
| REJECTED                              |            |

**N. MAAFARU AIRPORT**  
AIRFIELD LIGHTING & LANDING AIDS

Drawing Title:  
CABLE ROUTE- POWERHOUSE TO GPU

Employer:  
REGIONAL AIRPORTS  
MINISTRY OF TOURISM

Funder:  
  
صندوق أبوظبي للتنمية  
ABU DHABI FUND FOR DEVELOPMENT

Contractor:  
  
TUFF

Consultant:  
  
HOCHTIEF  
INDIA

Supervision & Management Consultant:  
  
ARMSTRONG


|                                   |                |                 |
|-----------------------------------|----------------|-----------------|
| Issue: AB                         | Date: AUG-2019 | Pages: 25 of 38 |
| Scale: N.T.S                      | Paper: A3      |                 |
| DWG #: T1713-TOS-33000-CV-DW-0025 |                |                 |



ISOLATING TRANSFORMER BOX FOUNDATION FOR RUNWAY, TAXIWAY, APRON & TURNING PAD EDGE LIGHT

RUNWAY END LIGHT


PLAN

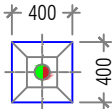

RUNWAY END LIGHTS  
MASS CONCRETE FOUNDATION  
SIZE: 400 X 400

RUNWAY EGDE LIGHT


PLAN

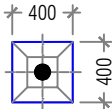

RUNWAY EDGE LIGHTS  
MASS CONCRETE FOUNDATION  
SIZE: 400 X 400


TAXIWAY, APRON & TURNING PAD EDGE LIGHT

PLAN

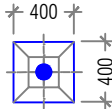

TAXIWAY, APRON & TURNING PAD EDGE LIGHT  
MASS CONCRETE FOUNDATION  
SIZE: 400 X 400

CROSS SECTION

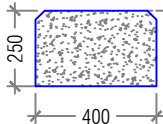


SCALE: NTS


TOP LVL IS TO FINISHED EDGE LVL OF CORRESPONDING  
PAVEMENT( RUNWAY, TAXIWAY, TURNPAD, APRON)

TAXIWAY BOARD FOUNDATION

PLAN

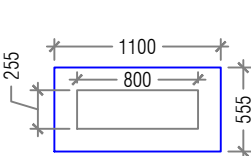


CROSS SECTION

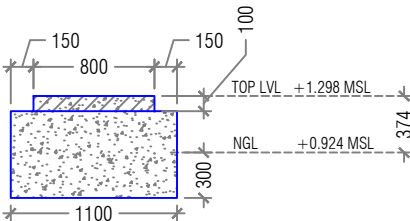


WIND CONE FOUNDATION

PLAN

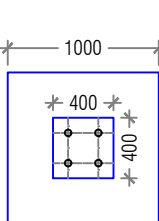


CROSS SECTION

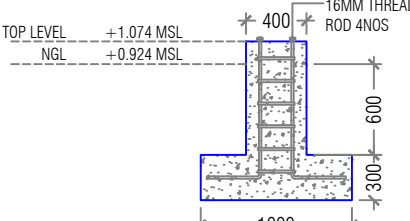


ABBREVIATED PRECISION APPROACH PATH INDICATOR (APAPI) FOUNDATION



PLAN

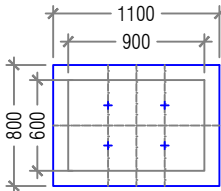

SECTION

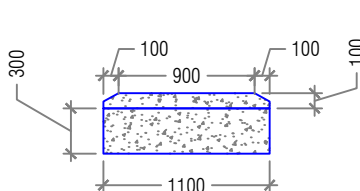


SHALL BE CAST IN THE PRESENCE OF LIGHTING ENGINEER.

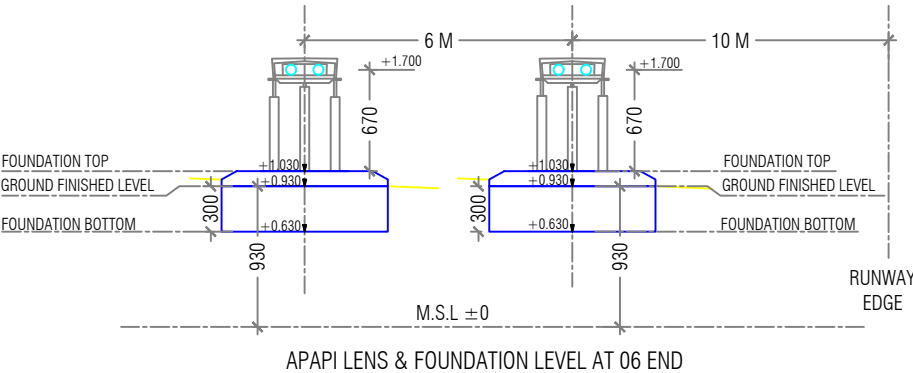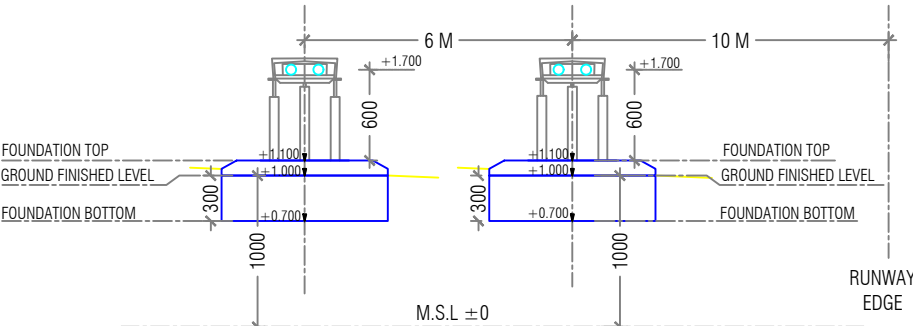

APRON MAST FOUNDATION

CROSS SECTION

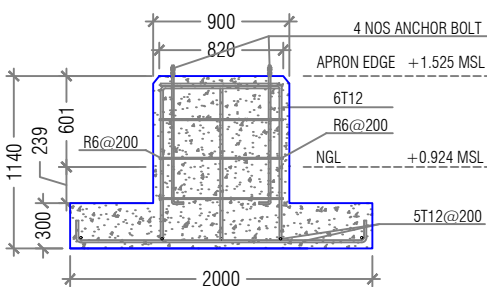


PLAN

APRON MAST  
RC FOUNDATION PAD 2000 X 2000 X 300  
RC COLUMN STUMP 900 X 900 X 601

AS-BUILT

KEY PLAN

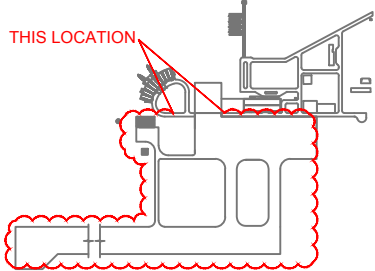

M. PRABHU  
CONSULTANT SIGNATURE

19-08-2019  
DATE

APPROVAL OF REGIONAL AIRPORT  
MALDIVES

DATE

REFERENCE CONSTRUCTION DRAWING NUMBER  
T1713-TOS-33000-CV-DW-0026

REV  
A4

AS-BUILT

| Description | Date       |
|-------------|------------|
| AS-BUILT    | 19/08/2019 |

DRAWING STATUS ☒ APPROVED ☐ REJECTED

N. MAAFARU AIRPORT  
AIRFIELD LIGHTING &  
LANDING AIDS

Drawing Title:  
AGL FOUNDATION DETAILS

Employer:  
REGIONAL AIRPORTS  
MINISTRY OF TOURISM

Funder:  
  
سندوق أبوظبي للتنمية  
ABU DHABI FUND FOR DEVELOPMENT

Contractor:  
 TUFF

Consultant:  
 HOCHTIEF  
INDIA

Supervision & Management Consultant:  
 ARMSTRONG

Issue: AB Date: AUG-2019 Pages: 26 of 38

Scale: N.T.S Paper: A3

DWG #: T1713-TOS-33000-CV-DW-0026

GENERAL NOTE: ALL FOUNDATION DESIGNS ARE BASED ON SUPPLIERS SPECIFICATION OF LIGHTS, WINDCONE, APAPI, TAXIWAY BOARD & APRON MASTS.  
ALL FOUNDATIONS TO HAVE 50MM THICK LEAN CONCRETE. (C15 GRADE)

AGL FOUNDATION DETAILS



SCALE 1:50









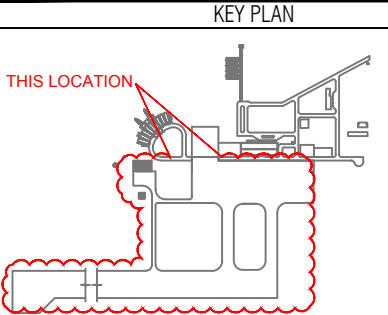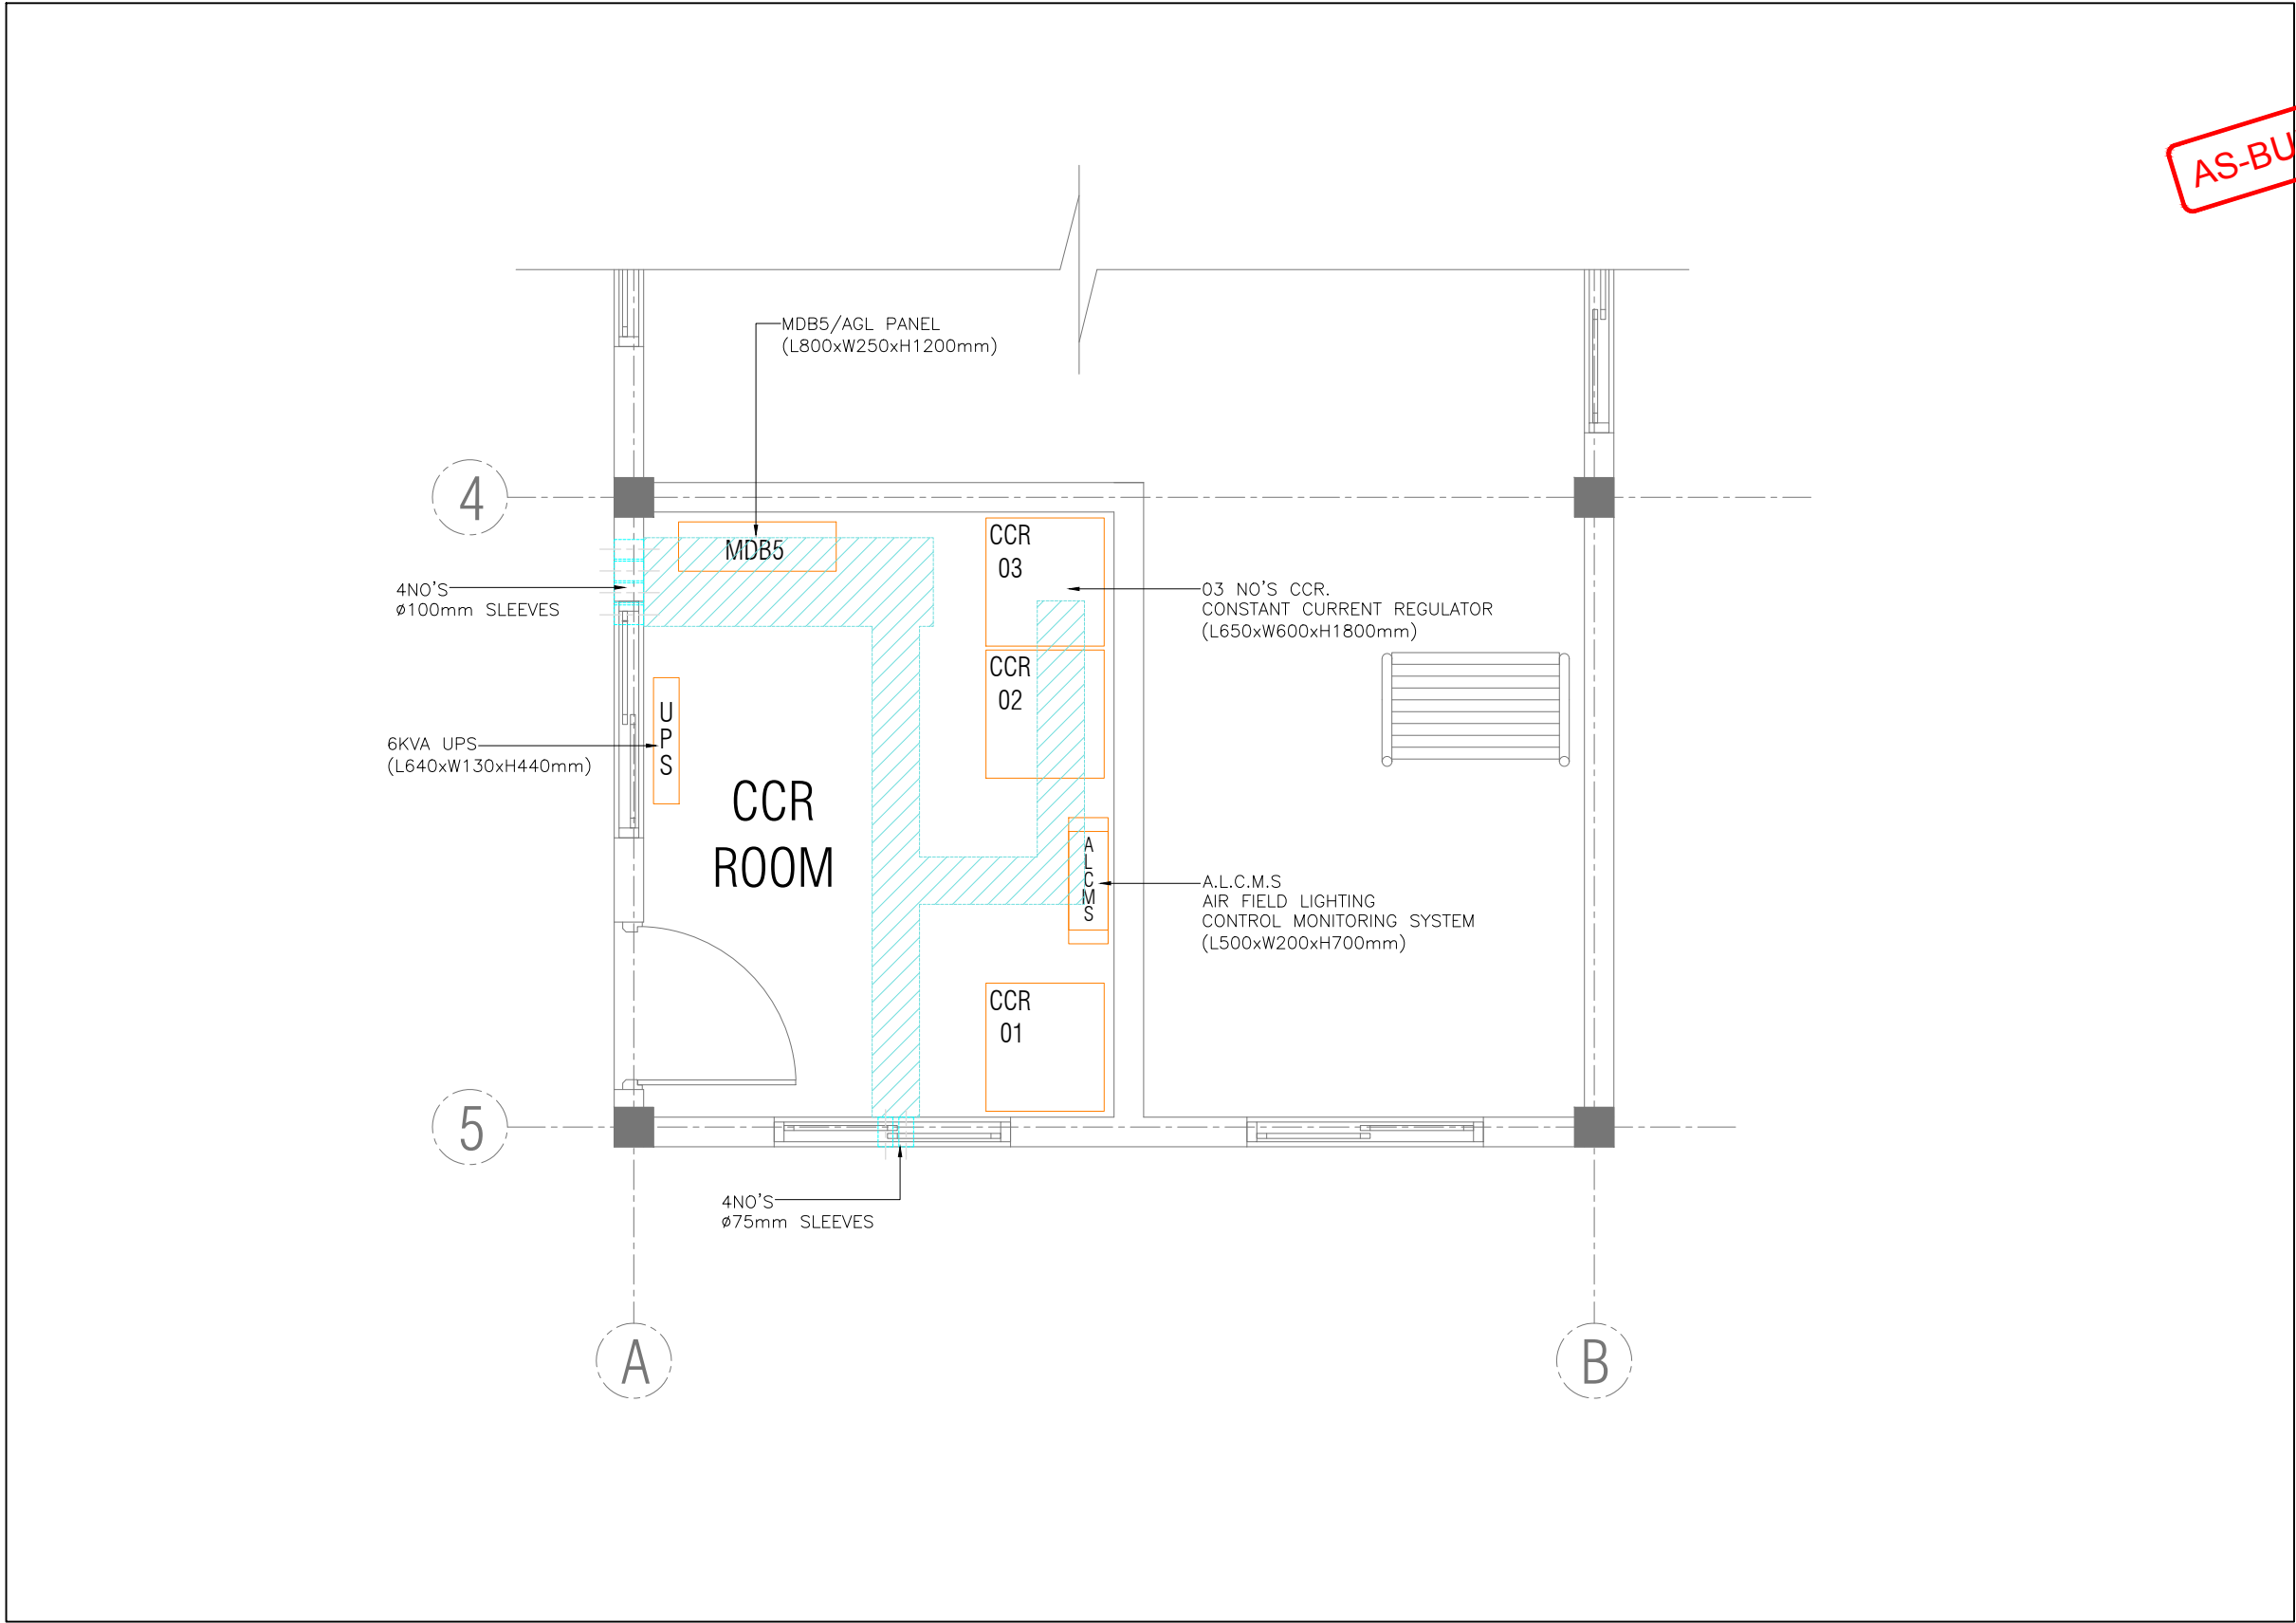

19-08-2019  
DATE  
M. PRABHU  
CONSULTANT SIGNATURE

APPROVAL OF REGIONAL AIRPORT  
MALDIVES  
DATE

|                                       |     |
|---------------------------------------|-----|
| REFERENCE CONSTRUCTION DRAWING NUMBER | REV |
| T1713-TOS-33000-CV-DW-0029            | A4  |

|             |            |
|-------------|------------|
| AS-BUILT    |            |
| Description | Date       |
| AS-BUILT    | 19/08/2019 |

DRAWING STATUS ☒ APPROVED ☐ REJECTED

**N. MAAFARU AIRPORT**  
AIRFIELD LIGHTING &  
LANDING AIDS

Drawing Title:  
CCR ROOM LAYOUT

Employer:  
**REGIONAL AIRPORTS**  
MINISTRY OF TOURISM




Funder:  
  
صندوق أبوظبي للتنمية  
**ABU DHABI FUND FOR DEVELOPMENT**

Contractor:  
  
**TUFF**

Consultant:  
  
**HOCHTIEF**  
INDIA

Supervision & Management Consultant:  
  
**ARMSTRONG**

|                                   |                |                 |
|-----------------------------------|----------------|-----------------|
| Issue: AB                         | Date: AUG-2019 | Pages: 29 of 38 |
| Scale: N.T.S                      | Paper: A3      |                 |
| DWG #: T1713-TOS-33000-CV-DW-0029 |                |                 |

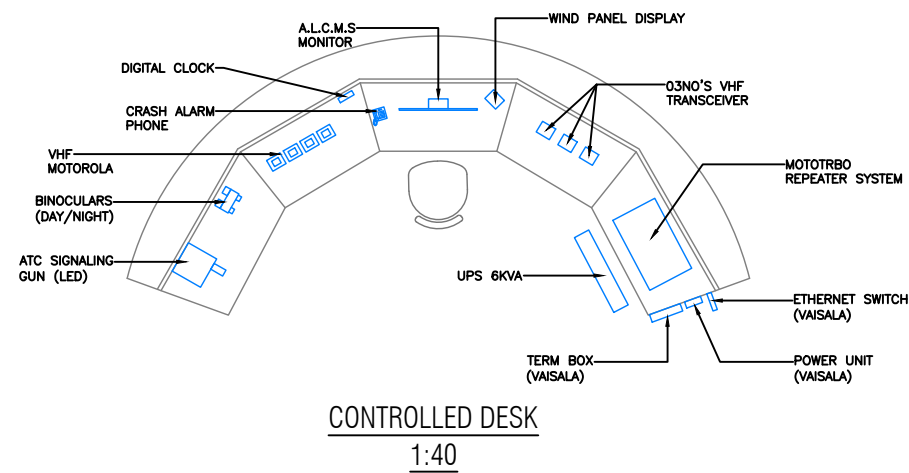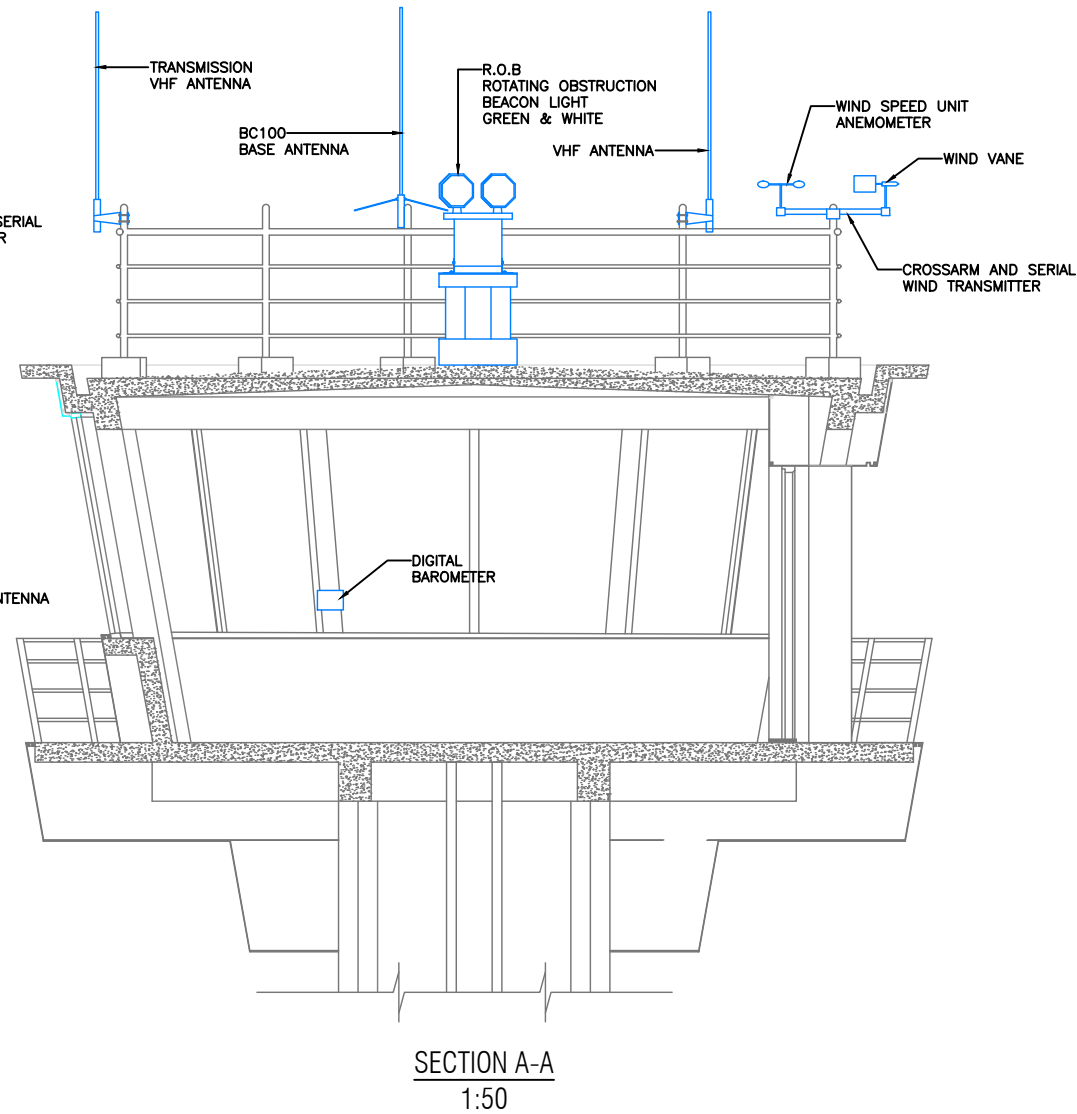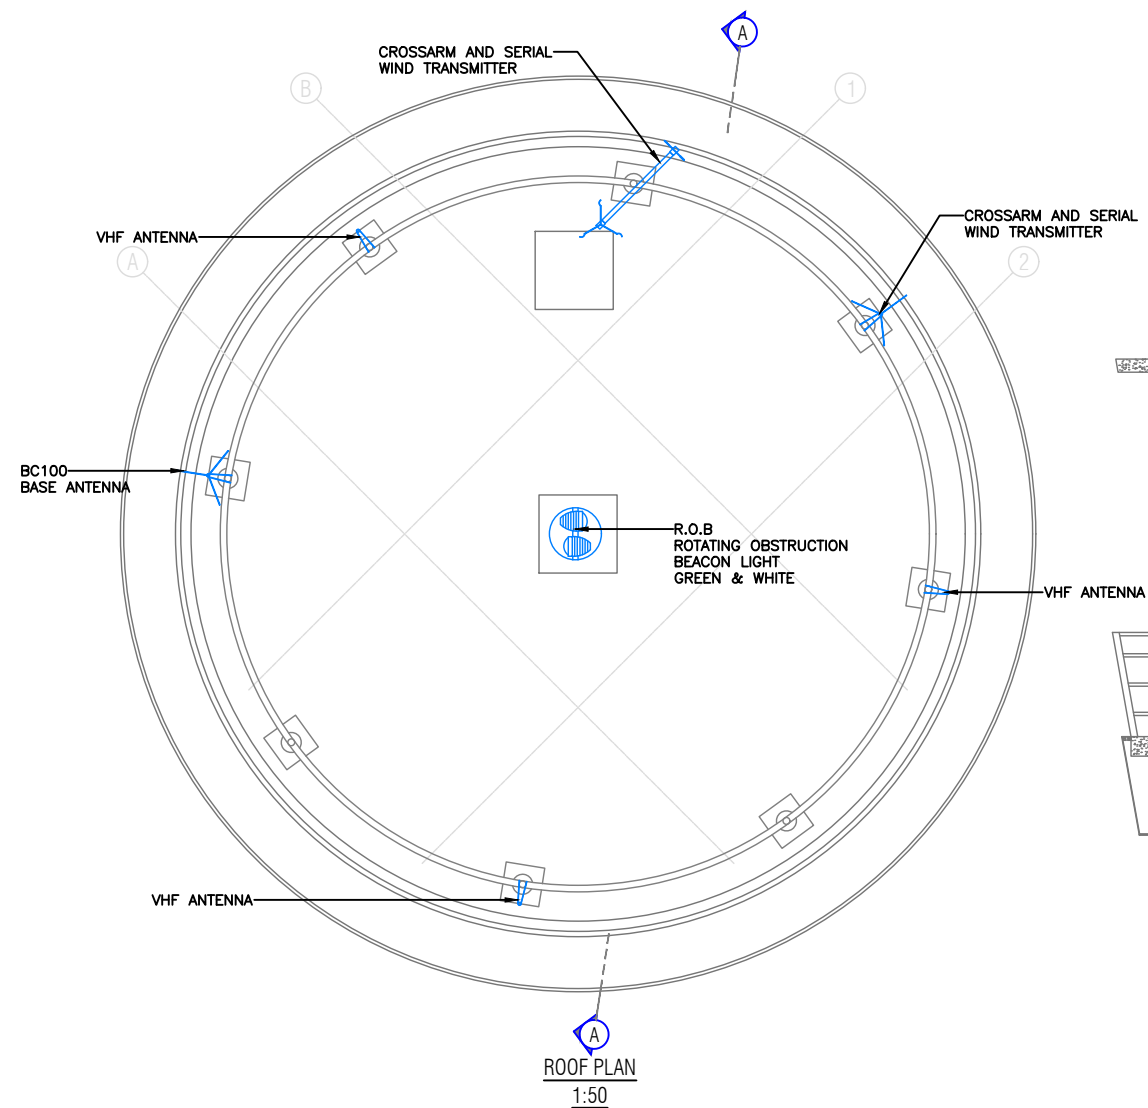

**AS-BUILT**

**KEY PLAN**

THIS LOCATION

19-08-2019  
DATE

M. PRABHU  
CONSULTANT SIGNATURE

APPROVAL OF REGIONAL AIRPORT  
MALDIVES

DATE

| REFERENCE CONSTRUCTION DRAWING NUMBER | REV |
|---------------------------------------|-----|
| T1713-TOS-33000-CV-DW-0030            | A4  |

AS-BUILT

| Description | Date       |
|-------------|------------|
| AS-BUILT    | 19/08/2019 |

DRAWING STATUS ☒ APPROVED ☐ REJECTED

**N. MAAFARU AIRPORT**  
AIRFIELD LIGHTING & LANDING AIDS

Drawing Title:  
ATC CONTROL DESK & EQUIPMENT LAYOUT

Employer:  
REGIONAL AIRPORT  
MINISTRY OF TOURISM

Funder:  
صندوق أبوظبي للتنمية  
ABU DHABI FUND FOR DEVELOPMENT

Contractor:  
**TUFF**

Consultant:  
**HOCHTIEF**  
INDIA


Supervision & Management Consultant:  
**ARMSTRONG**

|                                   |                |                 |
|-----------------------------------|----------------|-----------------|
| Issue: AB                         | Date: AUG-2019 | Pages: 30 of 38 |
| Scale: N.T.S                      | Paper: A3      |                 |
| DWG #: T1713-TOS-33000-CV-DW-0030 |                |                 |

AS-BUILT

COORDINATES FOR AFL


Scale NTS

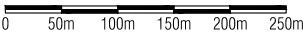

NOTE:

COORDINATE FORMAT: EASTING /NORTHING / Z (ELEVATION FROM MSL)  
DESIGN DRAWING - AIRFIELD LIGHTING REV A4 - DATED 09/09/2018

| SYMBOL | DESCRIPTION                      | SIZE        | LENGTH |
|--------|----------------------------------|-------------|--------|
|        | CABLE TRENCH 8M FROM RUNWAY EDGE | 600 MM WIDE | 7218M  |
|        | SERVICE DUCT                     | -           | -      |
|        | EARTH PIT                        |             |        |

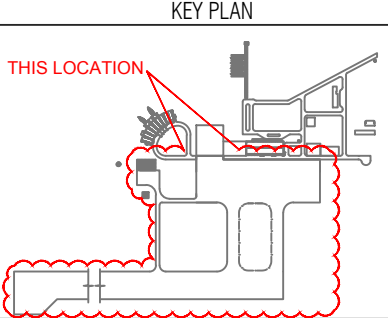

M. PRABHU  
CONSULTANT SIGNATURE

19-08-2019  
DATE

APPROVAL OF REGIONAL AIRPORT  
MALDIVES

DATE

REFERENCE CONSTRUCTION DRAWING NUMBER  
T1713-TOS-33000-CV-DW-0031

REV  
A4

| AS-BUILT    |            |
|-------------|------------|
| Description | Date       |
| AS-BUILT    | 19/08/2019 |

DRAWING STATUS ☒ APPROVED ☐ REJECTED

N. MAAFARU AIRPORT  
AIRFIELD LIGHTING &  
LANDING AIDS

Drawing Title:  
CABLE TRENCH COORDINATES

Employer:  
REGIONAL AIRPORTS  
MINISTRY OF TOURISM



Funder:



صندوق أبوظبي للتنمية  
ABU DHABI FUND FOR DEVELOPMENT

Contractor:



Consultant:



Supervision & Management  
Consultant:



Issue: AB Date: AUG-2019 Pages: 31 of 38


Scale: N.T.S Paper: A3

DWG #: T1713-TOS-33000-CV-DW-0031

SEE DETAIL C


SEE DETAIL B

SEE DETAIL A

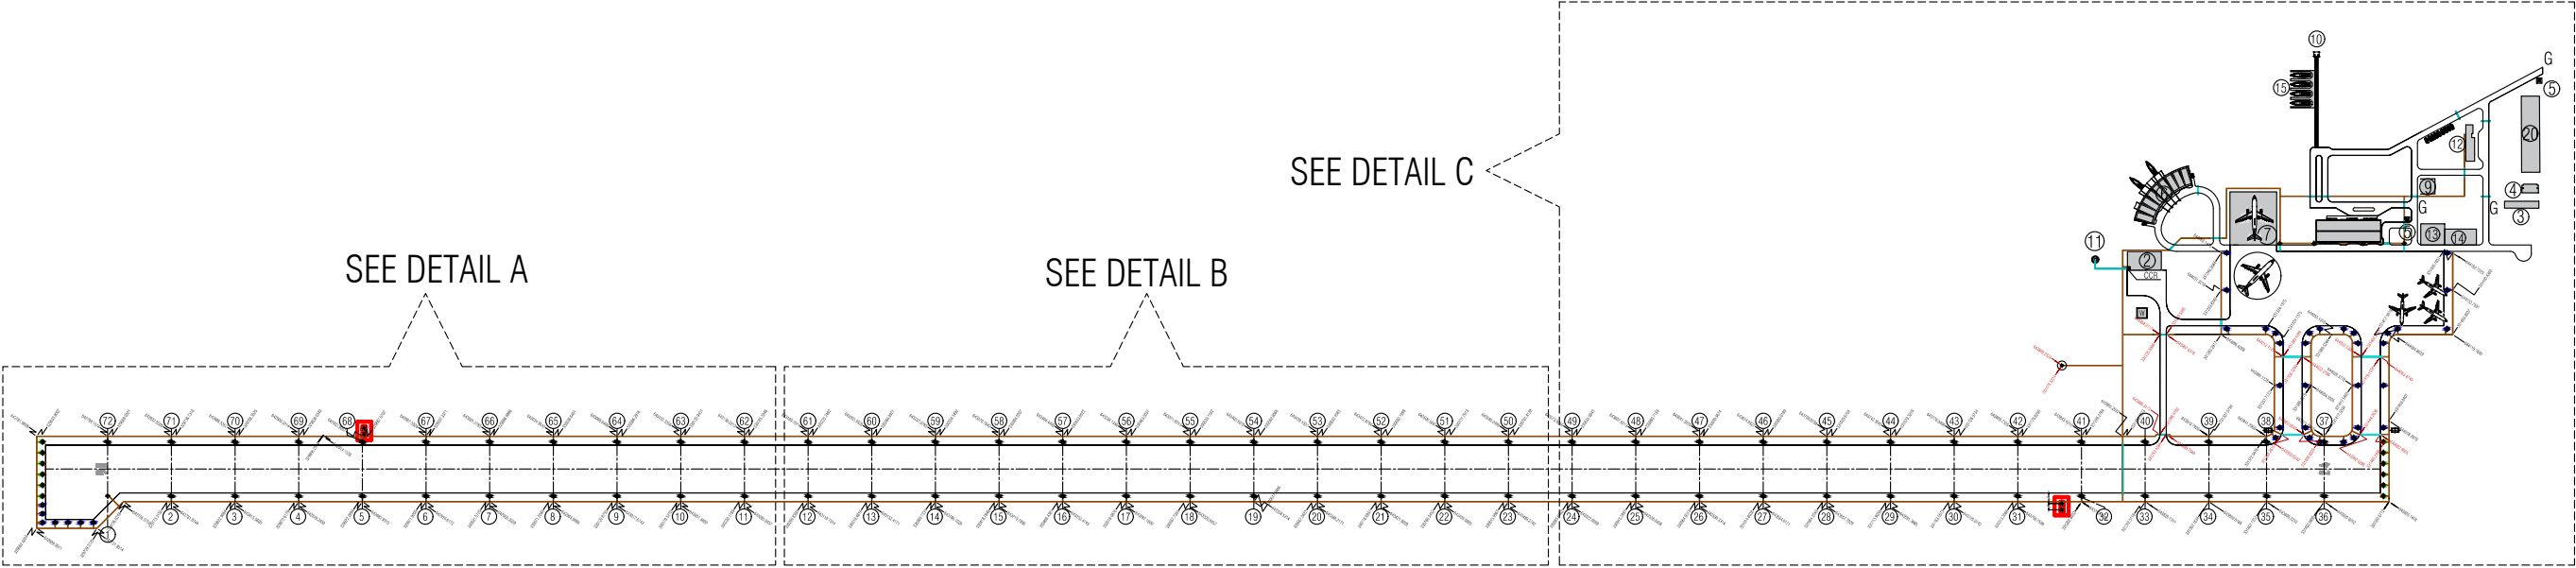

AS-BUILT

DETAIL A

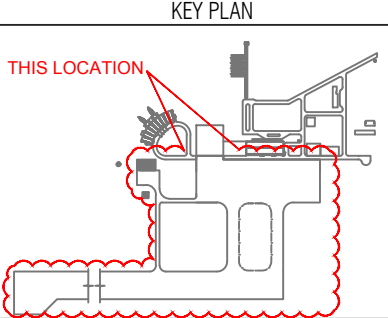

|                              |            |
|------------------------------|------------|
| .....                        | 19-08-2019 |
| M. PRABHU                    | DATE       |
| CONSULTANT SIGNATURE         |            |
| .....                        | .....      |
| APPROVAL OF REGIONAL AIRPORT | DATE       |
| MALDIVES                     |            |

|                                       |     |
|---------------------------------------|-----|
| REFERENCE CONSTRUCTION DRAWING NUMBER | REV |
| T1713-TOS-33000-CV-DW-0032            | A4  |

|             |            |
|-------------|------------|
| AS-BUILT    |            |
| Description | Date       |
| AS-BUILT    | 19/08/2019 |

DRAWING STATUS ☒ APPROVED ☐ REJECTED

N. MAAFARU AIRPORT  
AIRFIELD LIGHTING &  
LANDING AIDS

Drawing Title:  
CABLE TRENCH COORDINATES

Employer:

REGIONAL AIRPORTS  
MINISTRY OF TOURISM


Funder:

صندوق أبوظبي للتنمية  
ABU DHABI FUND FOR DEVELOPMENT

Contractor:



Consultant:

Supervision & Management  
Consultant:

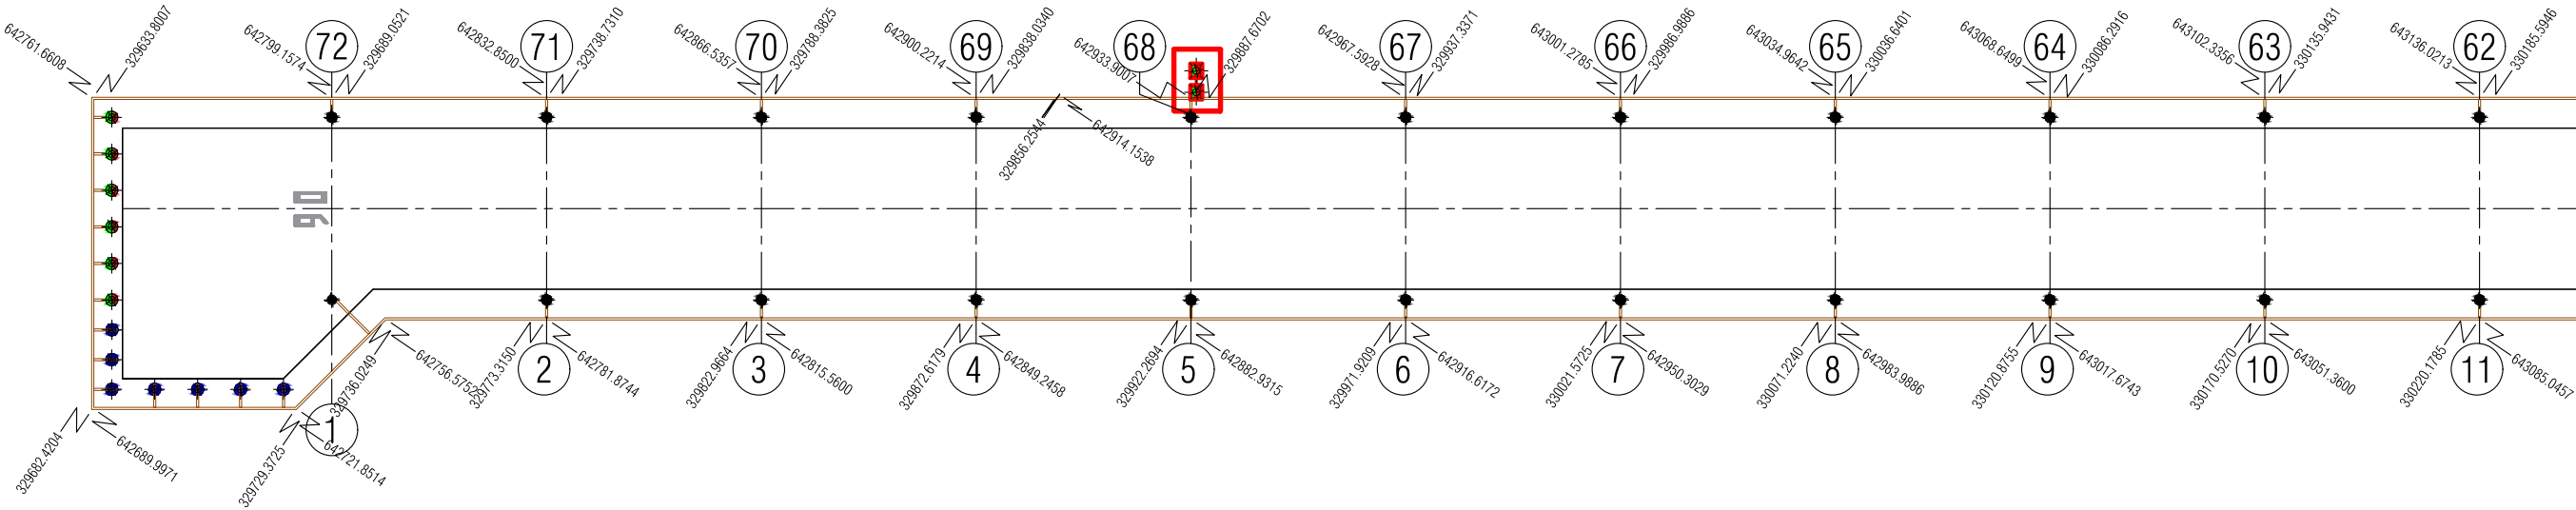

AS-BUILT

DETAIL B

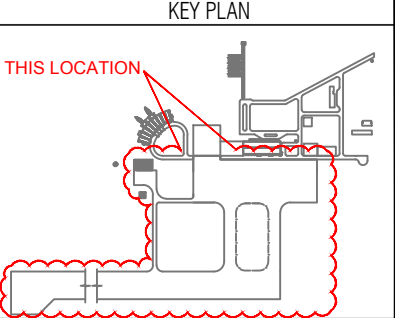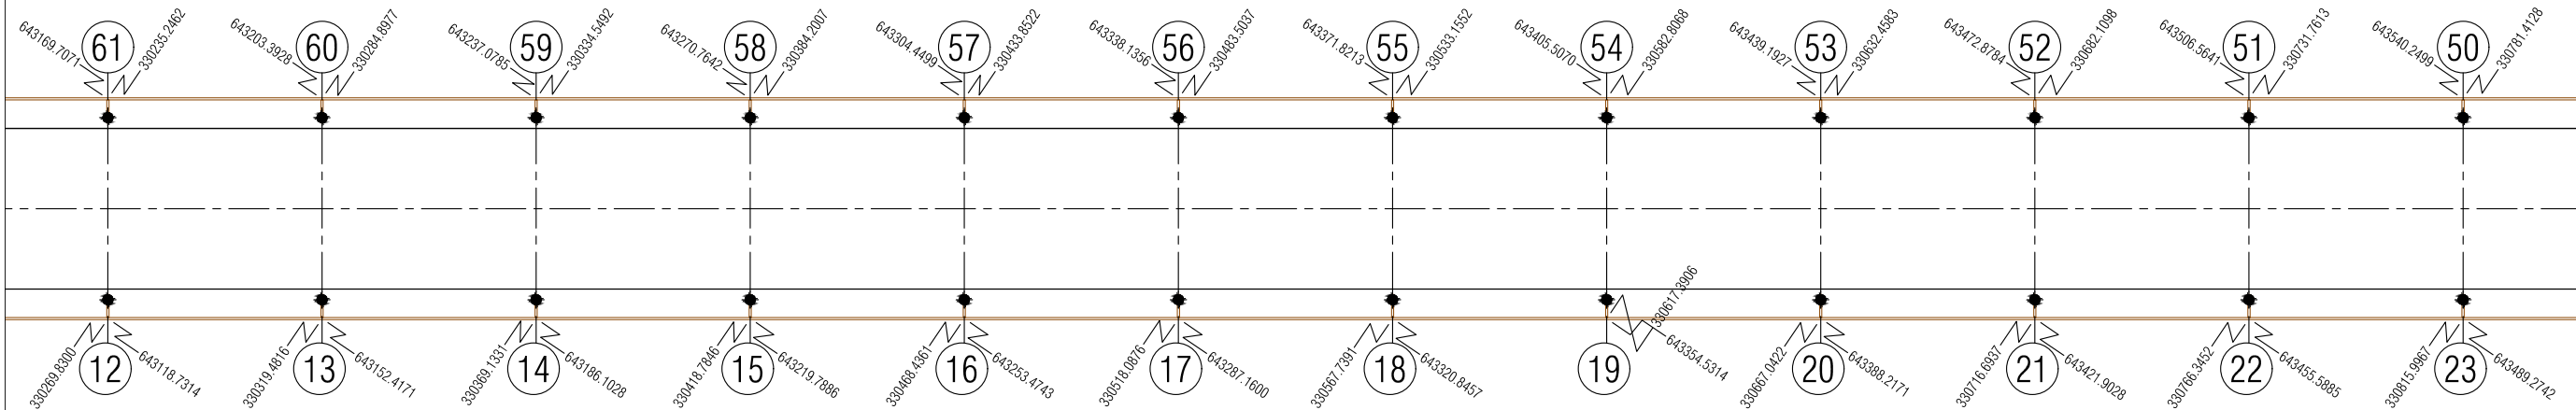

|                              |            |
|------------------------------|------------|
| .....                        | 19-08-2019 |
| M. PRABHU                    | DATE       |
| CONSULTANT SIGNATURE         |            |
| .....                        | .....      |
| APPROVAL OF REGIONAL AIRPORT | DATE       |
| MALDIVES                     |            |

|                                       |     |
|---------------------------------------|-----|
| REFERENCE CONSTRUCTION DRAWING NUMBER | REV |
| T1713-TOS-33000-CV-DW-0033            | A4  |

| AS-BUILT    |            |
|-------------|------------|
| Description | Date       |
| AS-BUILT    | 19/08/2019 |

DRAWING STATUS ☒ APPROVED ☐ REJECTED

**N. MAAFARU AIRPORT**  
**AIRFIELD LIGHTING & LANDING AIDS**

Drawing Title:  
CABLE TRENCH COORDINATES

Employer:

**REGIONAL AIRPORTS**  
MINISTRY OF TOURISM



Funder:



صندوق أبوظبي للتنمية  
**ABU DHABI FUND FOR DEVELOPMENT**

Contractor:




**TUFF**

Consultant:



Supervision & Management Consultant:



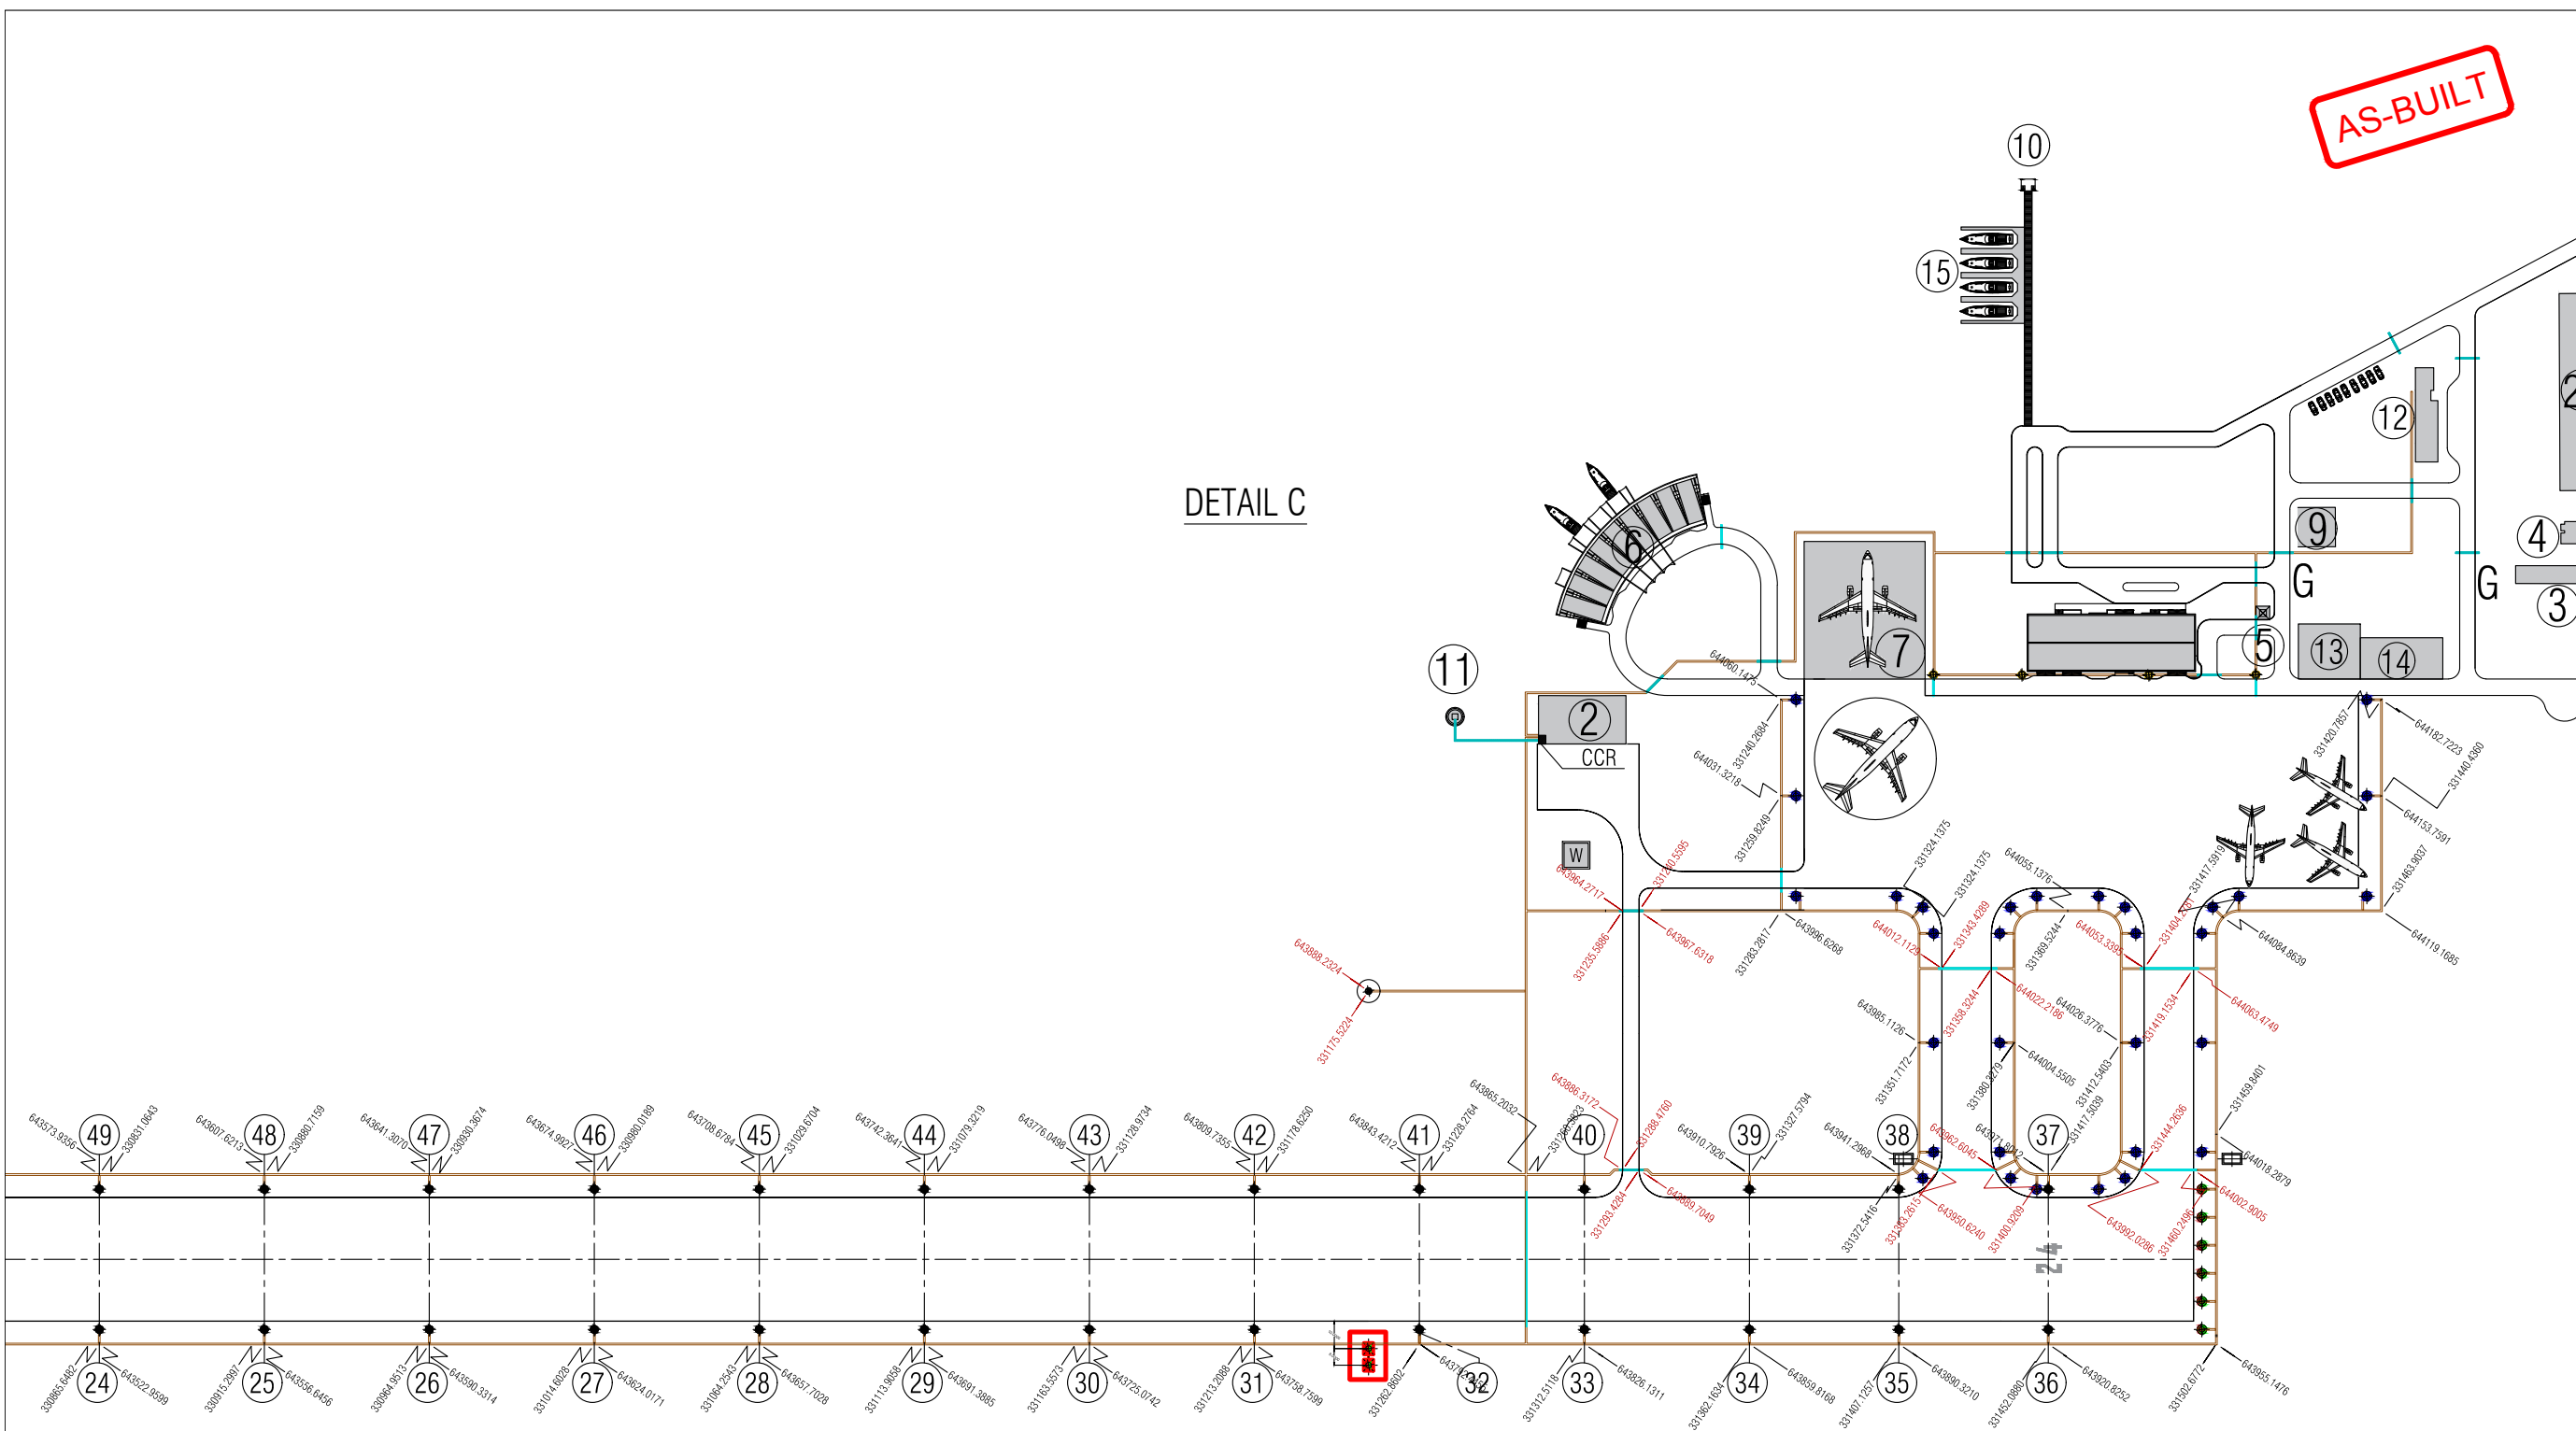

KEY PLAN

THIS LOCATION

M. PRABHU

CONSULTANT SIGNATURE

19-08-2019

DATE

APPROVAL OF REGIONAL AIRPORT

MALDIVES

DATE

REFERENCE CONSTRUCTION DRAWING NUMBER

T1713-TOS-33000-CV-DW-0034

REV

A4

AS-BUILT

Description

Date

AS-BUILT

19/08/2019

DRAWING STATUS

APPROVED

REJECTED

N. MAAFARU AIRPORT

AIRFIELD LIGHTING &

LANDING AIDS

Drawing Title:

CABLE TRENCH COORDINATES

Employer:

REGIONAL AIRPORTS

MINISTRY OF TOURISM

Funder:

Contractor:

TUFF

Consultant:

HOCHTIEF

INDIA

Supervision & Management

Consultant:

ARMSTRONG

Issue: AB

Date: AUG-2019

Pages: 34 of 38


Scale: #####

Paper: A3

DWG #: T1713-TOS-33000-CV-DW-0034



COORDINATES FOR AFL

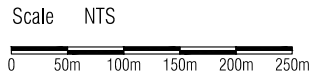


NOTE:

COORDINATE FORMAT: EASTING /NORTHING / Z (ELEVATION FROM MSL)

DESIGN DRAWING - AIRFIELD LIGHTING REV A4 - DATED 09/09/2018

| SYMBOL | DESCRIPTION                      | SIZE        | LENGTH |
|--------|----------------------------------|-------------|--------|
|        | CABLE TRENCH 8M FROM RUNWAY EDGE | 600 MM WIDE | 7218M  |
|        | EARTH PIT                        |             |        |

AS-BUILT

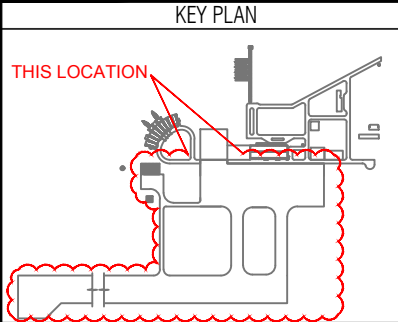

|                                       |            |
|---------------------------------------|------------|
| .....                                 | 19-08-2019 |
| M. PRABHU                             | DATE       |
| CONSULTANT SIGNATURE                  |            |
| .....                                 | .....      |
| APPROVAL OF REGIONAL AIRPORT          | DATE       |
| MALDIVES                              |            |
| REFERENCE CONSTRUCTION DRAWING NUMBER | REV        |
| T1713-TOS-33000-CV-DW-0035            | A4         |

|                |  |
|----------------|--|
| AS-BUILT       |  |
| Description    | Date   |
| AS-BUILT       | 19/08/2019   |
| DRAWING STATUS | <input checked="" type="checkbox"/> APPROVED <input type="checkbox"/> REJECTED |

**N. MAAFARU AIRPORT**  
**AIRFIELD LIGHTING & LANDING AIDS**

Drawing Title:  
EARTH PITS COORDINATES

Employer:  
**REGIONAL AIRPORTS**  
MINISTRY OF TOURISM


Funder:  
  
**صندوق أبوظبي للتنمية**  
**ABU DHABI FUND FOR DEVELOPMENT**


Contractor:

Consultant:

Supervision & Management Consultant:


|                                   |                |                 |
|-----------------------------------|----------------|-----------------|
| Issue: AB                         | Date: AUG-2019 | Pages: 35 of 38 |
| Scale: N.T.S                      | Paper: A3      |                 |
| DWG #: T1713-TOS-33000-CV-DW-0035 |                |                 |

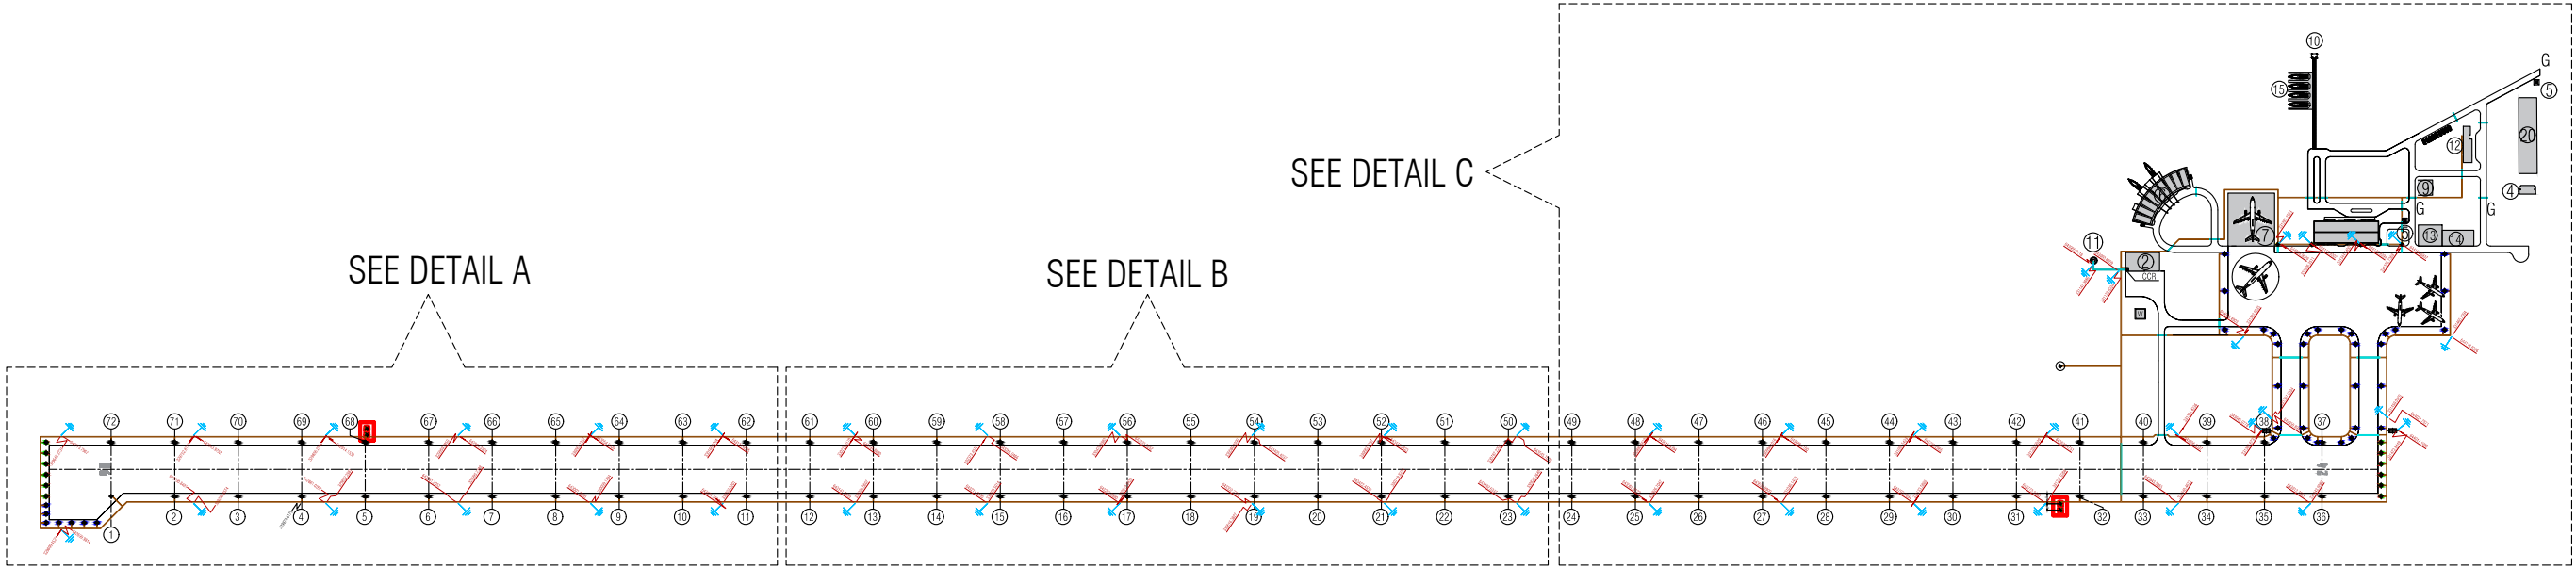

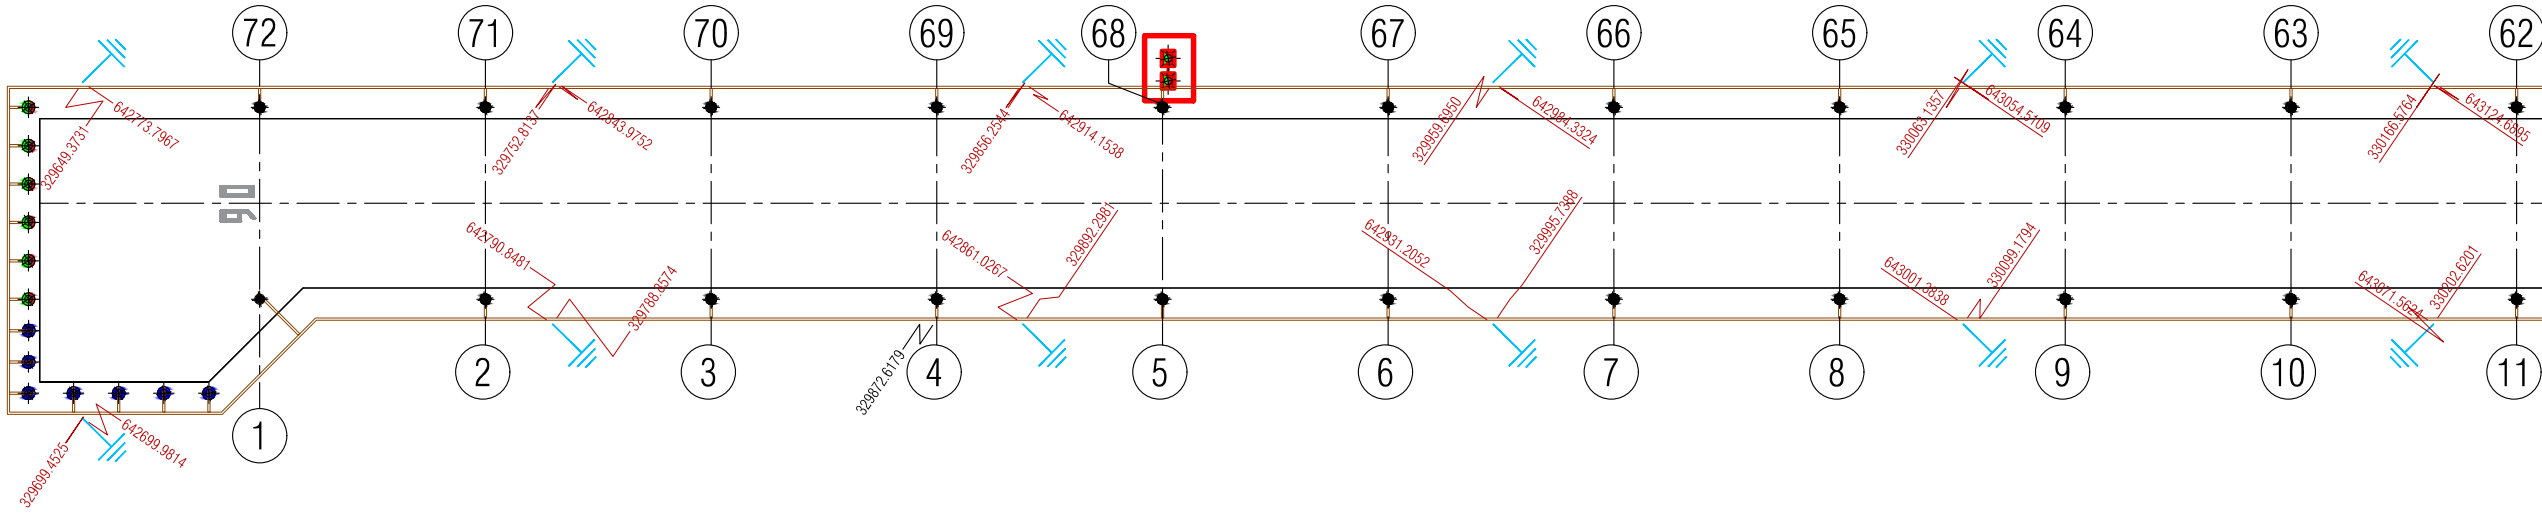

DETAIL A

AS-BUILT

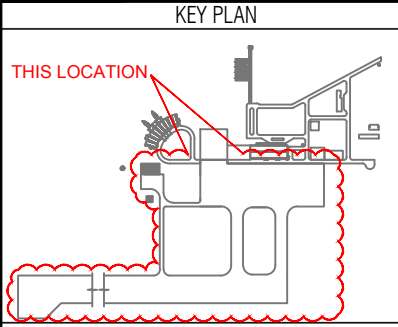

|                                       |      |
|---------------------------------------|------|
| 19-08-2019                            |      |
| M. PRABHU                             | DATE |
| CONSULTANT SIGNATURE                  |      |
| APPROVAL OF REGIONAL AIRPORT MALDIVES |      |
| DATE                                  |      |

| REFERENCE CONSTRUCTION DRAWING NUMBER | REV |
|---------------------------------------|-----|
| T1713-TOS-33000-CV-DW-0036            | A4  |

| AS-BUILT    |            |
|-------------|------------|
| Description | Date       |
| AS-BUILT    | 19/08/2019 |

DRAWING STATUS ☒ APPROVED ☐ REJECTED

N. MAAFARU AIRPORT  
AIRFIELD LIGHTING &  
LANDING AIDS

Drawing Title:  
EARTH PITS COORDINATES

Employer:

REGIONAL AIRPORTS  
MINISTRY OF TOURISM



Funder:



صندوق أبوظبي للتنمية  
ABU DHABI FUND FOR DEVELOPMENT

Contractor:



TUFF

Consultant:




HOCHTIEF  
INDIA

Supervision & Management Consultant:



ARMSTRONG



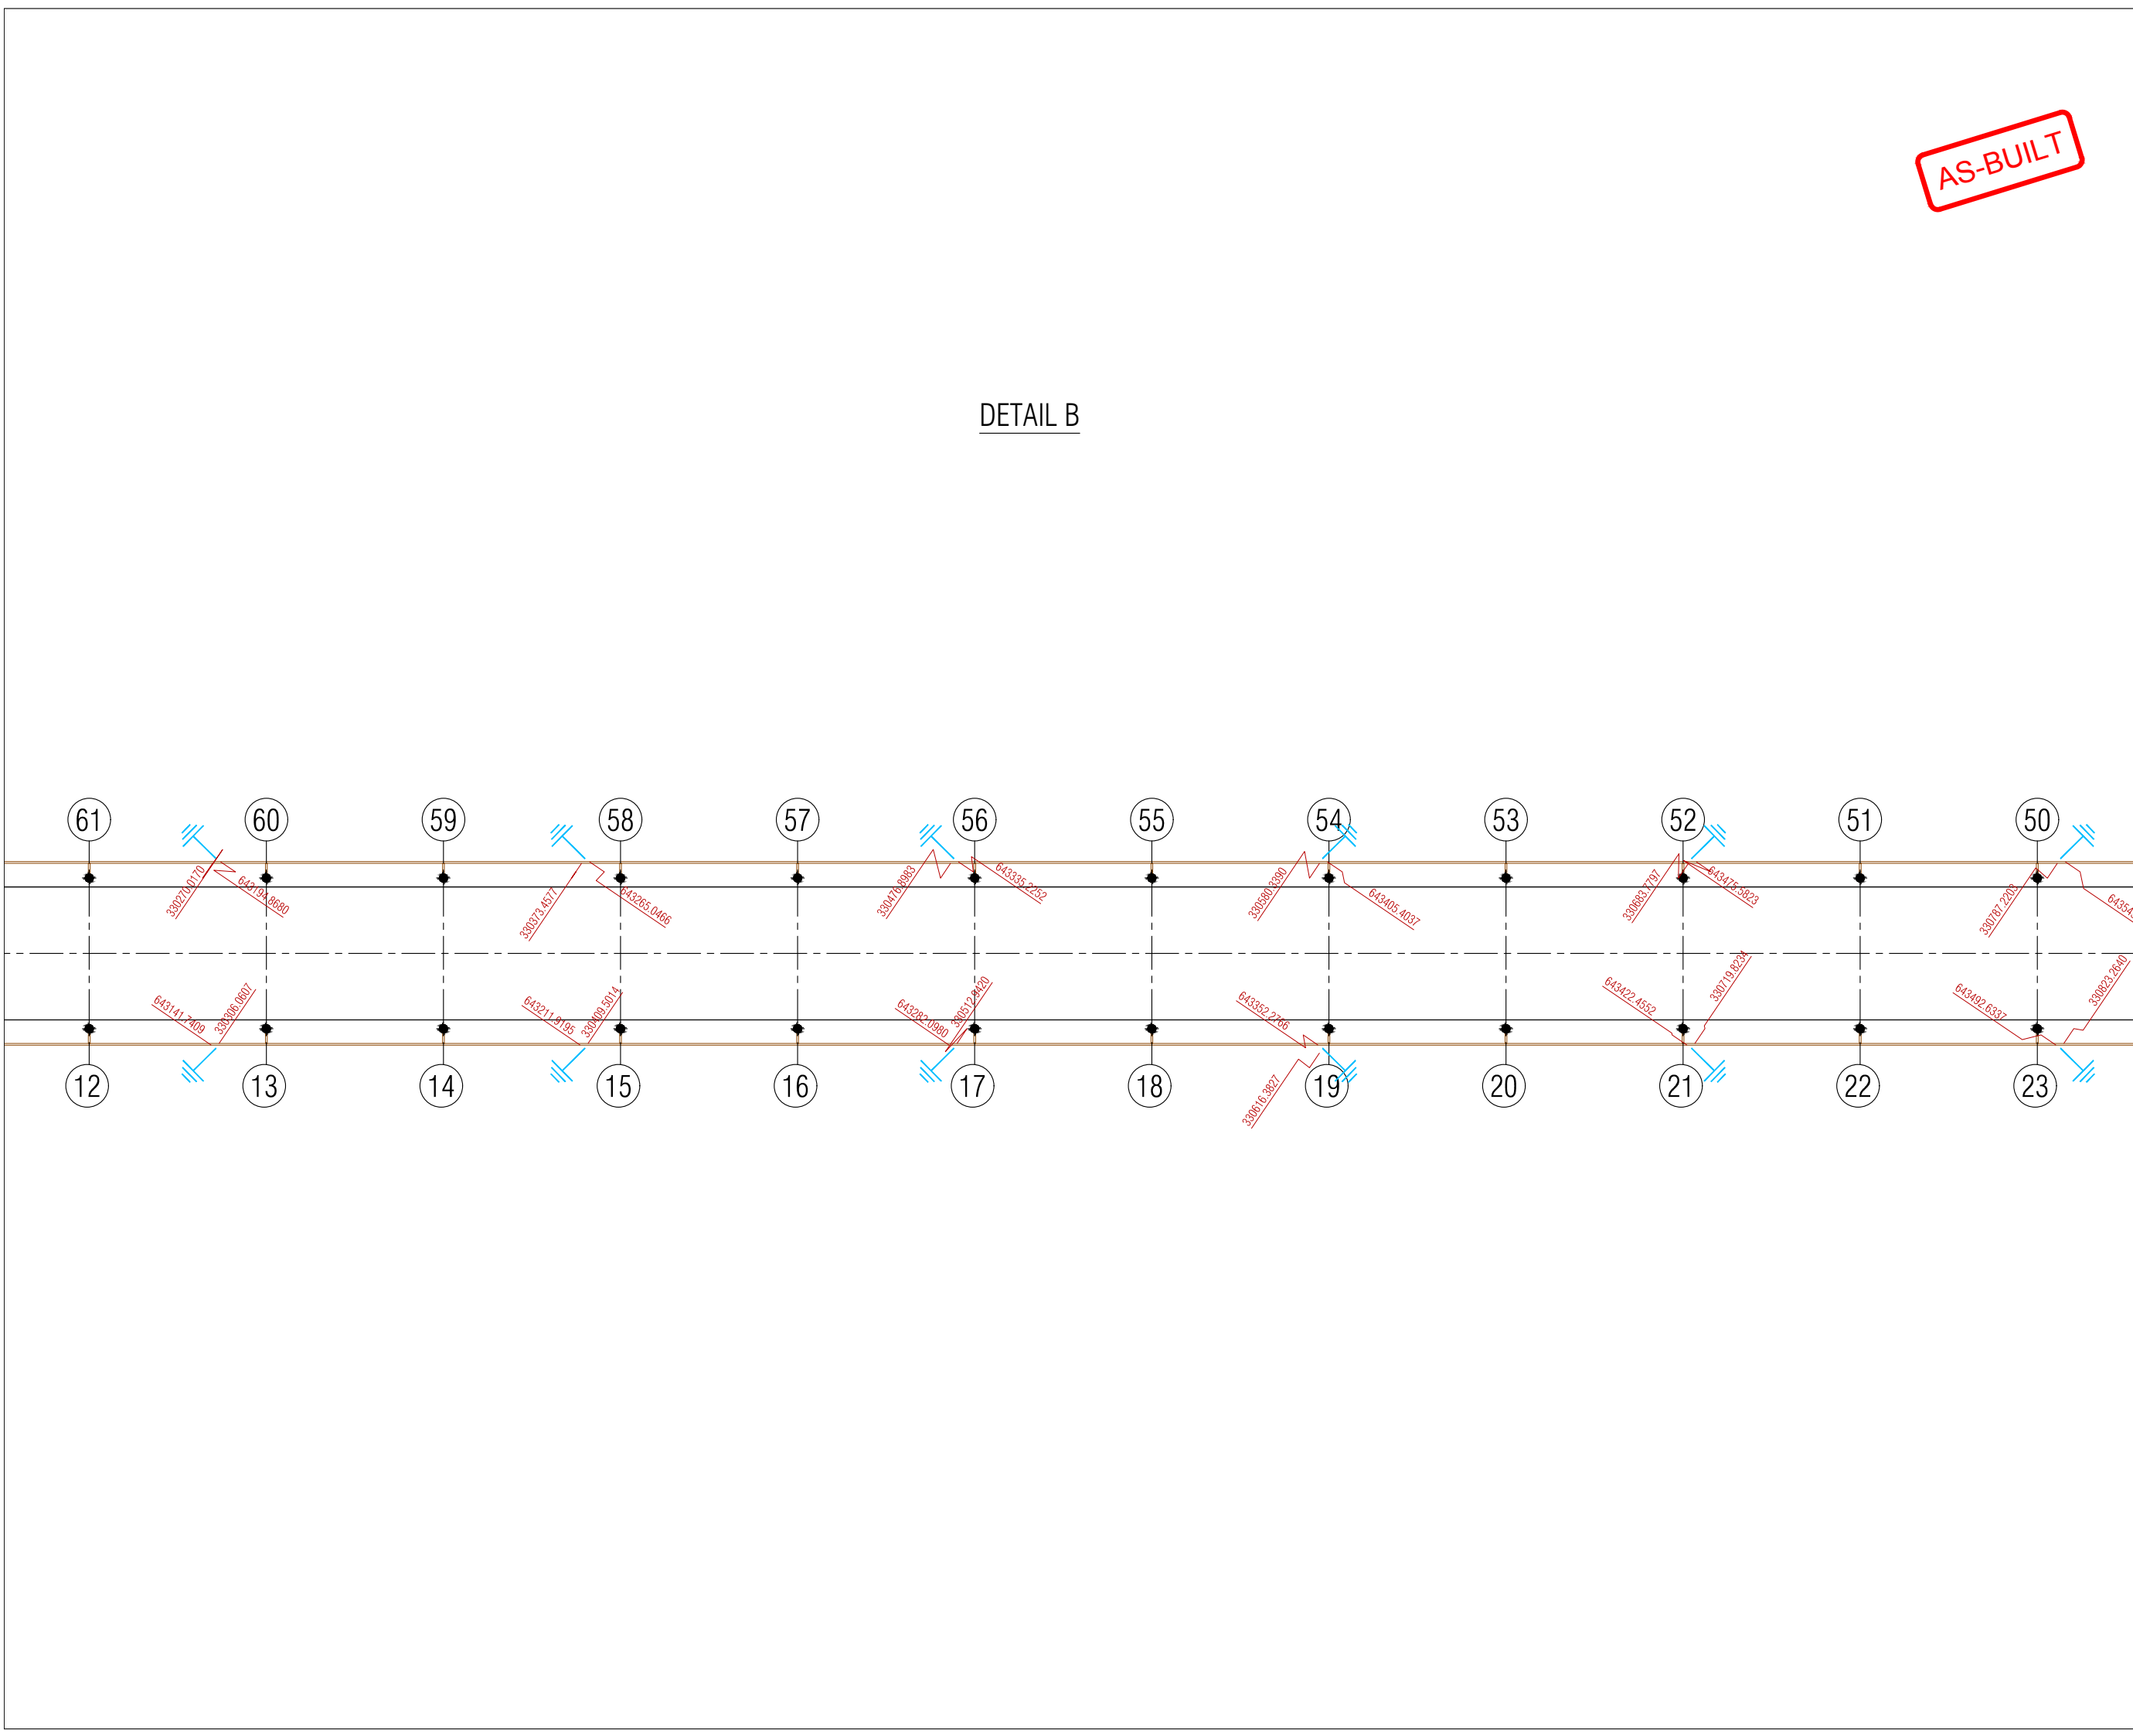

AS-BUILT

KEY PLAN



THIS LOCATION

M. PRABHU  
CONSULTANT SIGNATURE

19-08-2019  
DATE

APPROVAL OF REGIONAL AIRPORT  
MALDIVES

DATE

REFERENCE CONSTRUCTION DRAWING NUMBER

REV

T1713-TOS-33000-CV-DW-0037

A4

AS-BUILT

Description

Date

AS-BUILT

19/08/2019

DRAWING STATUS

APPROVED

REJECTED

N. MAAFARU AIRPORT

AIRFIELD LIGHTING &  
LANDING AIDS

Drawing Title:

EARTH PITS COORDINATES

Employer:

REGIONAL AIRPORTS  
MINISTRY OF TOURISM



Funder:



صندوق أبوظبي للتنمية  
ABU DHABI FUND FOR DEVELOPMENT

Contractor:



TUFF

Consultant:



HOCHTIEF  
INDIA

Supervision & Management Consultant:



ARMSTRONG

Issue: AB

Date: AUG-2019

Pages: 37 of 38

Scale: N.T.S

Paper: A3

DWG #: T1713-TOS-33000-CV-DW-0037

